

Rice

Map No. **KANSAS** Sec. 18 Twp 20 R. 9W

Well No. 7 Hickel Farm


Empire Company

Ft. from N. Line

990 Ft. from S. Line

Ft. from E. Line

990 Ft. from W. Line

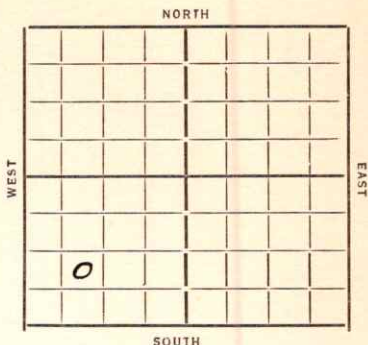

Date

REPORT

5/23 R. O. H.
5/31 Rigging up
6/7 Dlg 485 20" 92 15 1/2 395
6/14 " 1560 12 1/2 1212
6/21 " 2020 10" 1895
6/28 " 2300 8" 2275
7/5 UR 8" 2430
7/12 UR 8" 2588
7/19 Dlg 3055
7/26 T Sil ³³³⁸ 3348 6" 3347 5.0.
8/2 Correct Siliceous 3338
6" 3338 400' oil 3339
3341 trace of water PB 3340
8/9 TD 3341 208 oil 8w x 4 hrs.
8/15 Top Siliceous 3338
T. D. 3341
P. B. to 3340
208 bbls oil
8 bbls water

COMPLETED

KANSAS

Map No. 49 Sec. 18 Twp. 20 R. 9WWell No. 7-Heckel

Company

Contractor

FIRST REPORTS

SECTION PLAT

Ft. from N. Line

990 Ft. from S. Line

Ft. from E. Line

990 Ft. from W. Line

Location

RECORD

Cased _____ in., _____ ft.

Sand _____

Gas _____

Oil _____

Total Depth _____

PRODUCTION

1st 24 hrs. Nat. _____

1st 24 hrs. after shot _____

Gas _____ Cu. Ft.

Dry Hole _____

Abandoned _____

Date

5-23-34

19

ORVAL MANNSCHRECK Scout

Map No. 49 Sec. 18 Twp. 20 R. 9WWell No. 7-HeckelEmpire CompanyCOMPLETED Contractor

SECTION PLAT

0			

 Ft. from N. Line990 Ft. from S. Line Ft. from E. Line990 Ft. from W. LineLocation Rig up

Drilling and Remarks:

P.B. 3340208 oil
8 water

RECORD

Cased in., ft.Sand silicious 3338Gas Oil Total Depth 3341

PRODUCTION

1st 24 hrs. Nat. 1st 24 hrs. after shot Gas Cu. Ft.Dry Hole Abandoned

Date

8-15-34 19

ORVAL MANNSCHRECK

Scout