


Map No. **KANSAS** Sec. *11* Twp. *26* R. *2 E*
Well No. *17 21^e Gray* Farm
J. B. Shick Company

..... Ft. from N. Line
214 Ft. from S. Line
..... Ft. from E. Line
810 Ft. from W. Line

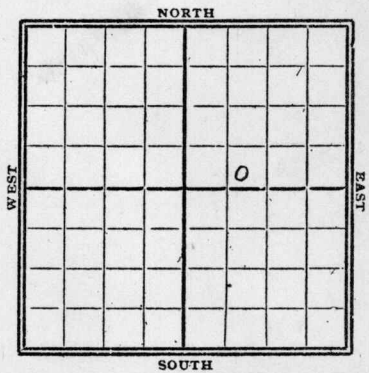

1929

Date

REPORT

<i>6/19</i>	<i>Spud</i>
<i>6/26</i>	<i>dry 2305'</i>
<i>1/2</i>	<i>dry 2965 chat 2897-2907</i>
<i>7/10</i>	<i>Pen 8" - 3080'</i>
<i>7/17</i>	
<i>7/24</i>	<i>Base line 3114'</i> <i>Top Simpson 3170</i> <i>show oil 3170-72'</i> <i>HFW 3177-80'</i>
<i>7/31</i>	<i>HFW 3177-80'</i> <i>T.D. 3180</i> <i>Abandoned</i>

Map No. **KANSAS** Sec. 11 Twp. 26 R. 2E

Well No. 1 Mc Kay

T. B. Slick Company

Contractor

SECTION PLAT

..... Ft. from N. Line

214 Ft. from S. Line

..... Ft. from E. Line

810 Ft. from W. Line

		0	

FIRST REPORTS

Location.....

Rig up.....

Drilling and Remarks:

Spud

RECORD

Cased.....in.,ft.

Sand.....

Gas.....

Oil.....

Total Depth.....

PRODUCTION

1st 24 hrs. Nat.....

1st 24 hrs. after shot.....

Gas.....Cu. Ft.

Dry Hole.....

Abandoned.....

Date

JUN 19 1929

S. J. LEWIS

Scout

Sedgwick

213

KANSAS

Map No. _____ Sec. 11 Twp. 26 R. 2^E

Well No. 1 *Mc Kay*

J. B. Slick

Company _____

Contractor _____

COMPLETE

SECTION PLAT

_____ Ft. from N. Line

214 Ft. from S. Line

_____ Ft. from E. Line

810 Ft. from W. Line

		o	
		1/2	

ABANDONED

Location _____

Rig up _____

Drilling and Remarks:

NFW 3177-80

RECORD

Cased _____ in., _____ ft.

Sand _____

Gas _____

Oil _____

Total Depth 3180

PRODUCTION

1st 24 hrs. Nat. _____

1st 24 hrs. after shot _____

Gas _____ Cu. Ft.

Dry Hole

Abandoned

Date

JUL 31 1929

CHAS. L. SHERWOOD