


Rice  
18 20 9W

Map No. \_\_\_\_\_ Sec. \_\_\_\_\_ Twp. \_\_\_\_\_ R. \_\_\_\_\_  
Well No. 9-Heckel Farm \_\_\_\_\_  
Empire Oil Company \_\_\_\_\_

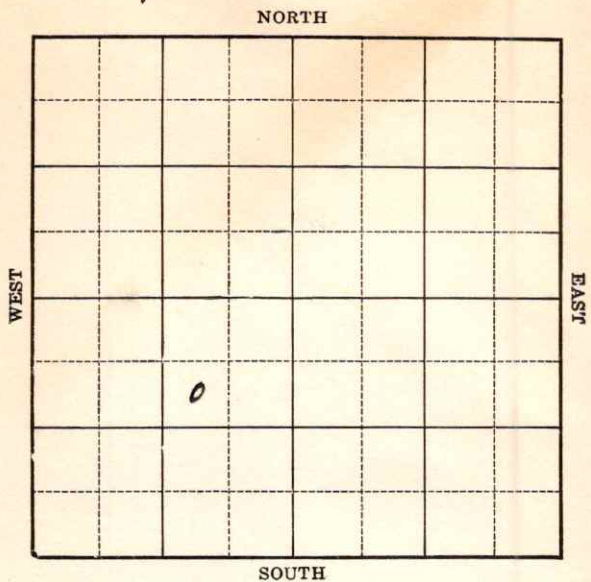

Location \_\_\_\_\_  
Drilling Remarks \_\_\_\_\_  
\_\_\_\_\_  
\_\_\_\_\_  
Rig Up \_\_\_\_\_  
Drilling Remarks \_\_\_\_\_  
\_\_\_\_\_  
\_\_\_\_\_  
RECORD

Cased \_\_\_\_\_ in. \_\_\_\_\_ ft.  
Sand \_\_\_\_\_  
Gas \_\_\_\_\_  
Oil \_\_\_\_\_  
Total Depth \_\_\_\_\_


PRODUCTION

1st 24 hrs. Nat. \_\_\_\_\_  
1st 24 hrs. after shot \_\_\_\_\_  
Gas \_\_\_\_\_ cu. ft.  
Dry Hole \_\_\_\_\_  
Abandoned \_\_\_\_\_

*Rice*

Map No. KANSAS Sec. 18 Twp. 20 R. 9W  
Well No. 9-Heckel Farm  
Empire Oil Company

990 Ft. from N. Line  
       Ft. from S. Line  
990 Ft. from E. Line  
       Ft. from W. Line

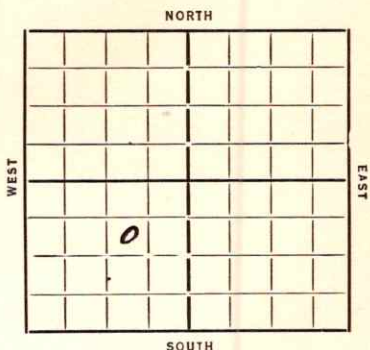

~~1925~~  
1925

REPORT

3/13 Bldg.  
3/21 Rgn  
3/28 Bldg 385  
4/4 12 1/2 1215  
4/11 Bldg 1865  
4/18 " 2330  
4/26 8" 2335 14 FEW 2540-50 WR 8"  
5/2 8" 2725  
5/9 Bldg 3107  
5/16 8" 3203 T 7 3244  
5/23 Bldg 3305 KC 2998  
5/28 Sil 3327 T 7 3333  
372 Bbls.

COMPLETED

KANSAS

Map No. 49 Sec. 18 Twp. 20 R. 9WWell No. 9-HeckelEmpire oil Company

Contractor

## FIRST REPORTS

## SECTION PLAT

990 Ft. from N. Line

Ft. from S. Line

990 Ft. from E. Line

Ft. from W. Line

|  |   |  |  |
|--|---|--|--|
|  |   |  |  |
|  |   |  |  |
|  |   |  |  |
|  | 0 |  |  |
|  |   |  |  |

Location

Rig up

Drilling and Remarks:

Bedg

## RECORD

Cased in., ft.

Sand

Gas

Oil

Total Depth

## PRODUCTION

1st 24 hrs. Nat.

1st 24 hrs. after shot

Gas Cu. Ft.

Dry Hole

Abandoned

Date

ORVAL MANNSCHRECK

3-13-35 192 Scout

Map No. K49 Sec. 18 Twp. 20 R. 9WWell No. 9. Herkel  
Empire oil Company

Contractor

COMPLETED

## SECTION PLAT

990 Ft. from N. Line

Ft. from S. Line

990 Ft. from E. Line

Ft. from W. Line

|  |   |  |  |
|--|---|--|--|
|  |   |  |  |
|  |   |  |  |
|  |   |  |  |
|  | 0 |  |  |
|  |   |  |  |

Location

Rig up

Drilling and Remarks:

372 lbs

## RECORD

Cased in., ft.

Sand oil 3327

Gas

Oil

Total Depth 3333

## PRODUCTION

1st 24 hrs. Nat.

1st 24 hrs. after shot

Gas Cu. Ft.

Dry Hole

Abandoned

Date

5-28-35 192

ORVAL MANNSCHRECK Scout