

Map No. KANSAS Sec. 11 Twp. 26 R. 2E

Well No. 1-Gracker Farm


Stelly Oil Company

NORTH

(Gracker)?

WEST

EAST

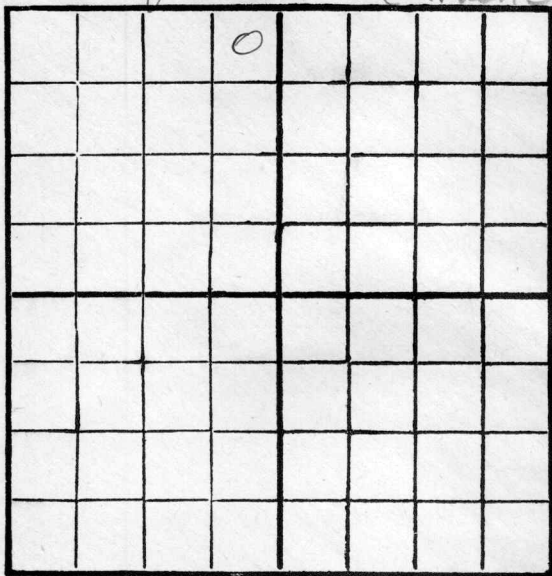

SOUTH

Location _____

Drilling Remarks

Rig Up _____

Drilling Remarks

RECORD

Cased _____ in. _____ ft.

Sand _____

Gas _____

Oil _____

Total Depth _____

PRODUCTION

1st 24 hrs. Nat. _____

1st 24 hrs. after shot _____


Gas _____ cu. ft. _____

Dry Hole _____

Abandoned _____

Sedgwick
 Map No. KANSAS Sec. 11 Twp. 26 R. 2^E
 Well No. 1-Dracher Farm
Kelly Oil Company

330 Ft. from N. Line
 _____ Ft. from S. Line
330 Ft. from E. Line
 _____ Ft. from W. Line

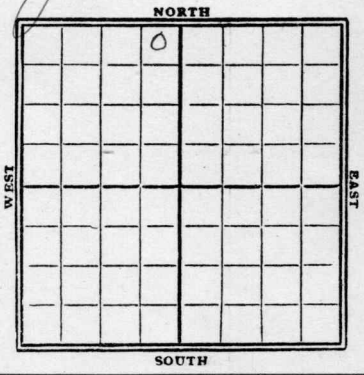

1929

Date	REPORT
7/17	Bddy Key
7/24	Regn up
7/31	spdy
8/7	Wrtg 775'
8/14	" 1690
8/21	" 2350'
8/28	" 2455'
9/6	chat 2880-83 Shew Oil 1500' water Wlg 2910 lime
9/16	Top limb 3200 T.D. 3505-HFW
9/18	Simpson 3200-05 T.D. 3205' HFW Abandoned

Seelgwick
 Map No. KANSAS Sec. 11 Twp. 26 R. 2E
 Well No. 1 Gracher

Skelly Oil Company
 Contractor

SECTION PLAT

	0		

030 Ft. from N. Line
 Ft. from S. Line
030 Ft. from E. Line
 Ft. from W. Line

FIRST REPORTS

Location.....
 Rig up.....
 Drilling and Remarks:

B.P.

RECORD

Cased.....in.,ft.
 Sand.....
 Gas.....
 Oil.....
 Total Depth.....

PRODUCTION

1st 24 hrs. Nat.....
 1st 24 hrs. after shot.....
 Gas.....Cu. Ft.
 Dry Hole.....
 Abandoned.....

Date

JUL 17 1939

S. J. LEWIS Scout

Map No. 130 **KANSAS** Sec. 11 Twp. 26 R. 2E

Well No. 1 Gracker

Spekly Oil Company

Contractor

SECTION PLAT

330 Ft. from N. Line

..... Ft. from S. Line

330 Ft. from E. Line

..... Ft. from W. Line

	0		

ABANDONED

Location.....

Rig up.....

Drilling and Remarks:

Compera 8200-05
HFW

RECORD

Cased..... in., ft.

Sand.....

Gas.....

Oil.....

Total Depth 8205

PRODUCTION

1st 24 hrs. Nat.....

1st 24 hrs. after shot.....

Gas..... Cu. Ft.

Dry Hole.....

Abandoned.....

Date

SEP 18 1929

S. J. LEWIS

192.....

Scout