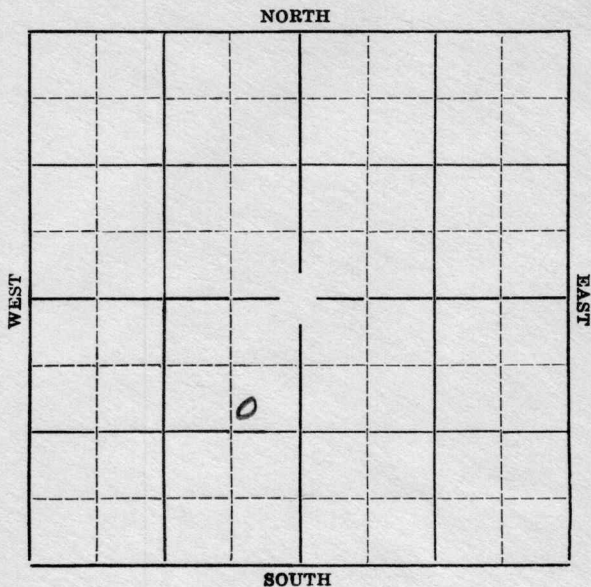


Section 11 Township 26 Range 2-EWell Number #3 StolleiCompany Alyward et al

Map No. KANSAS Sec. 11 Twp. 26 R. 2E

Well No. #3 Stollei Farm

Alyward et al Company

NORTH

WEST

EAST


SOUTH

1140' Ft. from N. Line

Ft. from S. Line

600' Ft. from E. Line

Ft. from W. Line

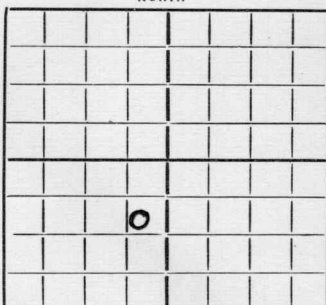

Date 1936

REPORT

7/15 Rigging up.

7/23 Drlg. 685'.

7/30 Drlg. 1760'.

8/6 Shut down.

8/13 Chat 2870'. T.D. 2900'. 1800' of fluid and 50' is water.

8/20 5" @ 3105'. Clean out.

8/27 Viola 3156'. Pump 416 bbls of oil plug 40% water.

9/3 Shut down.

9/23 /36-Viola 3156'.

T.D. 3156'.

600 gallons acid.

Potential 416 bbls of oil and 200 gbls of water.

COMPLETED

Seelquick
 Map No. 13 Sec. 11 Twp. 26 R. 24

Well No. 3 Stollci

Byward & Co Company

Contractor

SECTION PLAT

1140 Ft. from N. Line

_____ Ft. from S. Line

600 Ft. from E. Line

_____ Ft. from W. Line

FIRST REPORT

Location _____

Rig up _____

Drilling and Remarks:

Rigging up.

RECORD

Cased _____ in., _____ ft.

Sand _____

Gas _____

Oil _____

Total Depth _____

PRODUCTION

1st 24 hrs. Nat. _____

1st 24 hrs. after shot _____

Gas _____ Cu. Ft.

Dry Hole _____

Abandoned _____

Date

JUL 15 1936

19

S. J. LEWIS Scout

KANSAS

Map No. 13 Sec. 11 Twp. 26 R. 2EWell No. 3 StollerByward & Co CompanyByward & Co Contractor

SECTION PLAT

	0		

1140 Ft. from N. Line Ft. from S. Line600 Ft. from E. Line Ft. from W. Line

COMPLETED

Location Rig up

Drilling and Remarks:

Viola 3156.600 acidProd 416 oil200 water

RECORD

Cased in., ft.Sand Gas Oil Total Depth 3156

PRODUCTION

1st 24 hrs. Nat. 1st 24 hrs. after shot Gas Cu. Ft.Dry Hole Abandoned

Date

SEP 23 1936 19

S. J. LEWIS Scout