


Rice

KANSAS

Section 18 Township 20 Range 9-W
Well No. 10 Heckel
Company Empire

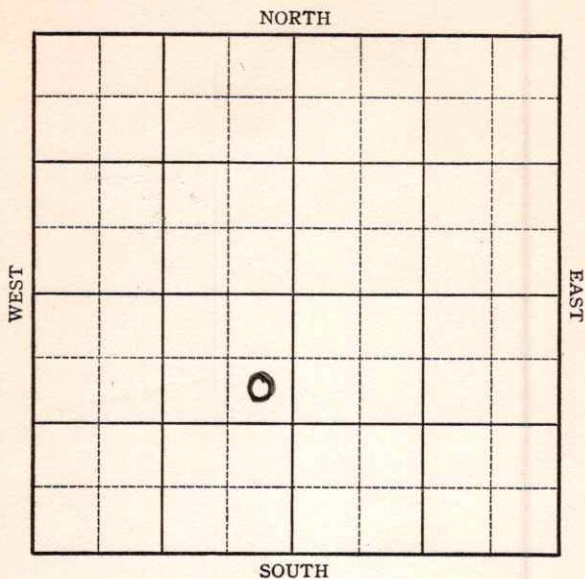


KANSAS

Rice

Sec. 18 Twp. 20 R. 9-WWell No. #10 Heckel FarmEmpire Company990 Ft. from N. Line Ft. from S. Line330 Ft. from E. Line Ft. from W. Line

Elev. 1804

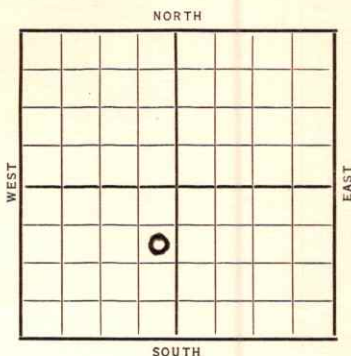

Date

REPORT

1937

5/26

B.R.

6/4

12" @ 240'. WOC.

6/11

Drlg. 1550'.

6/19

T.D. 2741' Fsg.

6/25

Coring 3341'.

7/2

Sil. & 7" @ 3345'. RUST.

7/7

7" @ 3342' (Corrected)

Sil. 3342' (Corrected)

T.D. 3345'.

Pot. 666 bbls. Nat.

COMPLETED

Rice **KANSAS**Map No. _____ Sec. 18 Twp. 20 R. 9^WWell No. 10-HeckelEmpire Company_____
Contractor

FIRST REPORT

SECTION PLAT

990 Ft. from N. Line

_____ Ft. from S. Line

330 Ft. from E. Line

_____ Ft. from W. Line

Location _____

Rig up _____

Drilling and Remarks:

B.R.

RECORD

Cased _____ in., _____ ft.

Sand _____

Gas _____

Oil _____

Total Depth _____

PRODUCTION

1st 24 hrs. Nat. _____

1st 24 hrs. after shot _____

Gas _____ Cu. Ft.

Dry Hole _____

Abandoned _____

Date

MAY 26 1927 19H. D. Hatfield Scout

Rice KANSAS

Map No. 49 Sec. 18 Twp. 20 R. 9 WWell No. 10-HeckelEmpire Company

Contractor

COMPLETED

990 Ft. from N. Line

_____ Ft. from S. Line

330 Ft. from E. Line

_____ Ft. from W. Line

SECTION PLAT

Location _____

Rig up _____

Drilling and Remarks:

Pat-666

NAT.

RECORD

Cased 7 in., 3342 ft.Sand 511 3342Gas (corrected)

Oil _____

Total Depth 3345

PRODUCTION

1st 24 hrs. Nat. _____

1st 24 hrs. after shot _____

Gas _____ Cu. Ft.

Dry Hole _____

Abandoned _____

Date

JUL 7 1937 19

H. D. Hatfield Scout