


Section 19 Township 20 Range 9W
Well No. 1 Gizzell
Company McKnab Drlg. Co.

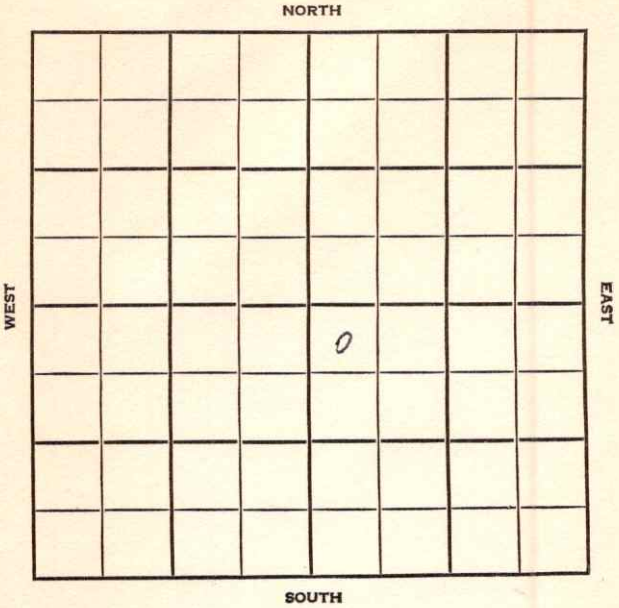

SEC.	TWP.	R.
19	20	9 W

WELL NO.

1 Gizzell

FARM

COMPANY

McKnab Drlg. Co.

CONTRACTOR

Co. Tools

Chase-Silica Pool

330

Ft. from N. Line


Ft. from S. Line

Ft. from E. Line

330

Ft. from W. Line

NW NW SE

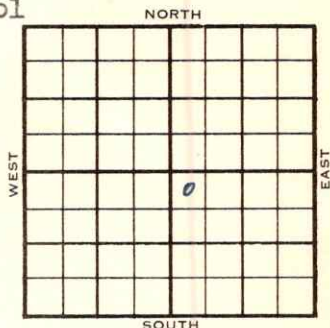

1954

ELEVATION

REPORT

9/22

Spud 9-10-54 D & A TD 3360'
 8" @ 125' Heeb 2853 Br 1m 2988
 TL 3012

DST 3052-3108, 60", rec 90' mud
 gas odor, BHP 120#-20" FP Off

Simp. 3320

DST 3321-33, 35", rec 20' mud. FP Off
 BHP 870# 20".

DST 3355-60', 60", rec 98' MCW,
 RTD 3360' No log.

D & A

FIRST REPORT**ABANDONED**

County **Rice** State **Kansas**
 Sec. **19** (Blk.) **20** (Sur.) **9W** Map No.
 Operator **McKnab Drlg. Co.**
 Well No. **1** Farm **Gizzell**
 Elev. Location **NW NW SE**



330 Ft. From **N** Line **SE**
330 Ft. From **W** Line Quarter
 1st. Report **SEP 22 1954**
 Completion **SEP 22 1954**
 Remarks **H. McNeil - Geol.**
Co. Tools
 Spudding Date **9/10/54**

Drlg. Data **D & A TD 3360 Chase-Silica Pool**
8" @ 125, Heeb 2853, Br Lm 2988, TL 3012,
DST 3052-3108 60" rec 90' md gas odor, BHP
120-20" FP-0#, Simp 3320, DST 3321-33, 35"
rec 20' mud FP-0#, BHP 870-20", DST 3355-60"
60" rec 98' mcw, RTD 3360, no log,
D. & A.

FABEN GILSTRAP