

Section 19 Township 20 Range 9W

Well No. 1 Malone

Company Bay Pet

Chase Pool
NORTH

NORTH

WEST

EAST

SOUTH

KANSAS

Rice

Sec. 19 Twp. 20 R. 9-W ✓

Well No. #1 Malone Farm

Bay Pet Company


Chase

990 Ft. from N. Line

990 Ft. from S. Line

990 Ft. from E. Line

_____ Ft. from W. Line

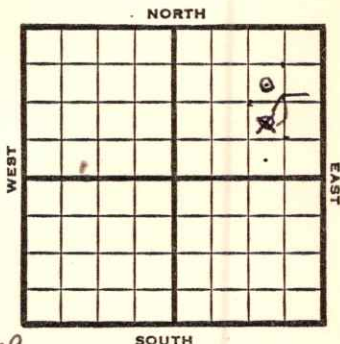

~~NW SE NE~~ *SW NE NE*

1948 **Eli 1805'** REPORT

9/29 8" @ 217'

10/6 **Lensing 3011'**
Drlg. 3166'

10/13 **Simpson 3333'**
5" @ 3333'
TD 3336'

10/19 **Arbuckle 3345'**
TD 3347'

10/27 2500 acid
TD 3350'
Simpson 3345'
5" @ 3333
Pump 100' oil Pot
42° Gr.
Comp

COMPLETED

Map No. _____ Sec. 19 Twp. 20 R. 9WWell No. 1 Malone

_____ Bay Pet. _____ Company

_____ FIRST REPORT _____ Contractor

NW SE NE

SECTION PLAT

_____ Ft. from N. Line

990 Ft. from S. Line990 Ft. from E. Line

_____ Ft. from W. Line

			o

Rice County

Location _____

Rig up _____

Drilling and Remarks:

8" @ 217

RECORD

Cased _____ in., _____ ft.

Sand _____

Gas _____

Oil _____

Total Depth _____

PRODUCTION

1st 24 hrs. Nat. _____

1st 24 hrs. after shot _____

Gas _____ Cu. Ft.

Dry Hole _____

Abandoned _____

Date

SEP 29 1948 19 _____ S. J. LEWIS Scout

Map No. 49 Sec. 19 Twp. 20 R. 9W

Well No. 1 Melone

Bay Pet. Company

CORRECTION

Contractor

SW NE NE

SECTION PLAT

990 Ft. from N. Line

 Ft. from S. Line

990 Ft. from E. Line

 Ft. from W. Line

Rice County

Location

Rig up

Drilling and Remarks:

Reported

NW SE NE

RECORD

Cased in., ft.

Sand

Gas

Oil

Total Depth

PRODUCTION

1st 24 hrs. Nat.

1st 24 hrs. after shot

Gas Cu. Ft.

Dry Hole

Abandoned

Date

OCT 6 1948 19

S. J. LEWIS

Scout

Map No. 49 Sec. 19 Twp. 20 R. 9W

Well No. 1 Malone

Bay Pet.

Company

COMPLETE

Contractor

SW NE NE

E1,1804
SECTION PLAT

990 Ft. from N. Line

Ft. from S. Line

990 Ft. from E. Line

Ft. from W. Line

			0

Rice County

Location

Rig up

Drilling and Remarks:

Dring 3345-
5, 103333

Pump 100 oil
BT

42°/4

RECORD

Cased _____ in., _____ ft.

Sand _____

Gas _____

Oil ☒

Total Depth 3300

PRODUCTION

1st 24 hrs. Nat. _____

1st 24 hrs. after shot _____

Gas _____ Cu. Ft.

Dry Hole _____

Abandoned _____

Date

OCT 27 1948

S. J. LEWIS

Scout