


Map No. **KANSAS** Sec. 19 Twp. 20 R. 9W *Rice*

Well No. 1- Malone Farm _____
Empire Oil Company _____

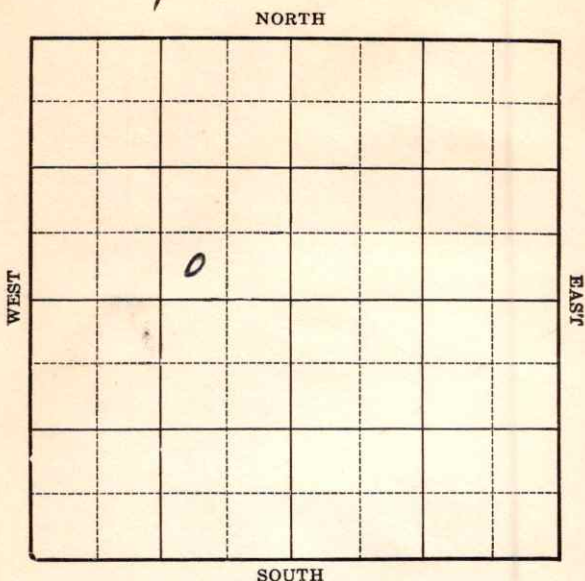

Location _____

Drilling Remarks _____

Rig Up _____

Drilling Remarks _____

RECORD

Cased _____ in. _____ ft.

Sand _____

Gas _____

Oil _____

Total Depth _____

PRODUCTION

1st 24 hrs. Nat. _____

1st 24 hrs. after shot _____

Gas _____ cu. ft.

Dry Hole _____

Abandoned _____

Rice

Map No. KANSAS Sec. 19 Twp. 20 R. 9W


Well No. #1 Malone Farm
Empire Oil Company

 Ft. from N. Line

330 Ft. from S. Line

990 Ft. from E. Line

 Ft. from W. Line

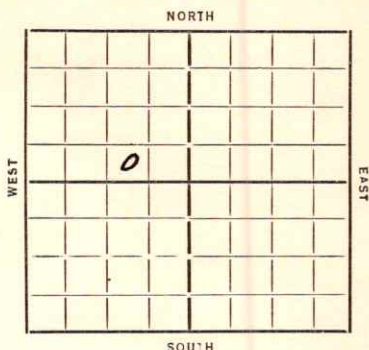

Date 1935 REPORT

<u>2/27</u>	<u>Location</u>	
<u>3/7</u>	<u>Rig</u>	
<u>3/14</u>	<u> </u>	
<u>3/21</u>	<u>dly 355</u>	<u>20" 102</u>
<u>3/28</u>	<u>" 1080</u>	<u>15" 397</u>
<u>4/4</u>	<u>" 1805</u>	<u>12" 1217</u>
<u>4/14</u>	<u>" 2385</u>	
<u>4/18</u>	<u>" 2710</u>	
<u>4/26</u>	<u>8" 2746</u>	<u>WR 8" 2861</u>
<u>5/2</u>	<u>dly 3110</u>	<u>8" 3000</u>
<u>5/9</u>	<u>RC 3029</u>	<u>8" 3242 CO.</u>
<u>5/16</u>	<u>Rimp 3340</u>	<u>Sil 3374</u>
	<u>1+FW 3376-84</u>	<u>dly 3420</u>
<u>5/23</u>	<u>dly 3565</u>	
<u>5/31</u>	<u>3631 TD</u>	
<u>6/6</u>	<u> </u>	
<u>6/13</u>	<u>PB 3450</u>	<u>8" 3400</u>
<u>6/20</u>	<u> </u>	<u>6/28</u>
<u>7/3</u>	<u>CO 3631</u>	
<u>7/11</u>	<u> </u>	<u>7/18</u>

(over)

7/24 T 7 3631

Use hole for water disposal

ABANDONED

Map No. 49 Sec. 19 Twp. 20 R. 9WWell No. 1- MaloneEmpire oil Company

Contractor

FIRST REPORTS

Ft. from N. Line

330 Ft. from S. Line790 Ft. from E. Line

Ft. from W. Line

SECTION PLAT

	0		

Location ✓

Rig up

Drilling and Remarks:

RECORD

Cased _____ in., _____ ft.

Sand _____

Gas _____

Oil _____

Total Depth _____

PRODUCTION

1st 24 hrs. Nat. _____

1st 24 hrs. after shot _____

Gas _____ Cu. Ft.

Dry Hole _____

Abandoned _____

Date

ORVAL MANNSCHRECK

2-27-35 192

Scout

KANSAS

Map No. 49 Sec. 19 Twp. 20 R. 9NWell No. 1 MaloneEmpire Oil Company

Contractor

ABANDONED

SECTION PLAT

Ft. from N. Line

230 Ft. from S. Line990 Ft. from E. Line

Ft. from W. Line

	0		

Location

Rig up

Drilling and Remarks:

D & A
hole
used for water
disposal

RECORD

Cased.....in.,ft.

Sand.....

Gas.....

Oil.....

Total Depth 3631

PRODUCTION

1st 24 hrs. Nat.....

1st 24 hrs. after shot.....

Gas.....Cu. Ft.

Dry Hole.....

Abandoned.....

Date

7/24/35 192

ORVAL MANNSCHRECK

Scout