

KANSAS

Rice

Sec. 19 Twp. 20 R. 9W ✓

Well No. #1 Malone "B" Farm _____
Bay Pet. _____ Company _____

Chase Pool


_____ Ft. from N. Line

990' Ft. from S. Line

990' Ft. from E. Line

_____ Ft. from W. Line

NW SE NE

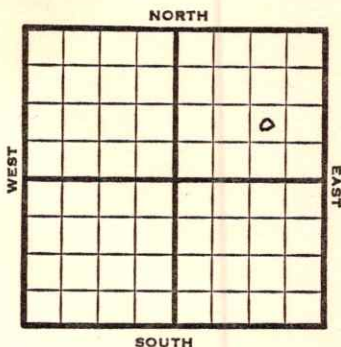

1949 **Elev 1809'** REPORT

4/13 8" @ 219'
Anhy. 940'
Drlg. 2370'

4/20 **Simpson sd 3361'**
TD 3363'
5" @ 3361'

4/27 Drlg 3369'
SSO &W

5/4 TD 3367'

5/10 **Arbuckle 3363'**
TD 3367'

5/18 "

5/25 TD 3367'
Arb. 3363'
Aband.

ABANDONED

Kansas

Map No. _____ Sec. 19 Twp. 20 R. 9WWell No. 1 Malone "B"Bay Pet. _____ Company

FIRST REPORT

Contractor _____


NW SE NE

SECTION PLAT

_____ Ft. from N. Line

990 Ft. from S. Line990 Ft. from E. Line

_____ Ft. from W. Line

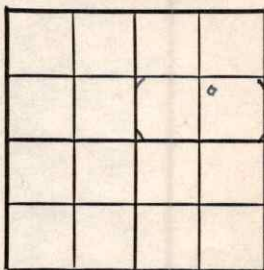

Rice County

Location _____

Rig up _____

Drilling and Remarks:

8" @ 219

Anhy 940

drlg. 2370

RECORD

Cased _____ in., _____ ft.

Sand _____

Gas _____

Oil _____

Total Depth _____

PRODUCTION

1st 24 hrs. Nat. _____

1st 24 hrs. after shot _____

Gas _____ Cu. Ft.

Dry Hole _____

Abandoned _____

Date

APR 13 1949 19S. J. LEWIS Scout

Kansas

Map No. K49 Sec. 19 Twp. 20 R. 9WWell No. 1 Malone "B"

Bay Pet. _____ Company _____

ABANDONED

Contractor _____

NW SE NE

E 1809
SECTION PLAT

_____ Ft. from N. Line

990 Ft. from S. Line990 Ft. from E. Line

_____ Ft. from W. Line

			d

Rice County

Location _____

Rig up _____

Drilling and Remarks:

Cost 3363

RECORD

Cased _____ in., _____ ft.

Sand _____

Gas _____

Oil _____

Total Depth 3367

PRODUCTION

1st 24 hrs. Nat. _____

1st 24 hrs. after shot _____

Gas _____ Cu. Ft.

Dry Hole _____

Abandoned _____

Date

MAY 25 1949 19

S. J. LEWIS

Scout