FORM 51 10M 7-48 PETROL

KANSAS


Barton

Section 17 Township 18 Range 13W

Well No. 2 Yeakley

Company Sohio et al

Yeakley Pool

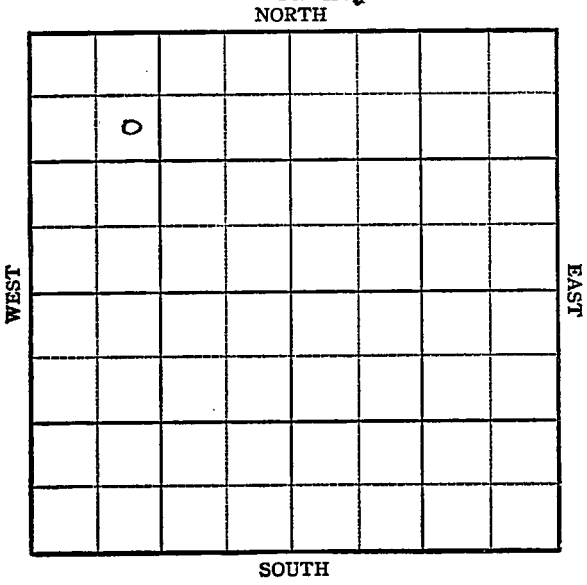

FORM 252-A
5M 10-48 PETROL

KANSAS

Barton

Sec. 17 Twp. 18 R. 13W

Well No. #2 Yeakley Farm

Sohio et al Company

Yeakley Pool


990' Ft. from N. Line

Ft. from S. Line

Ft. from E. Line

990' Ft. from W. Line

SW NW NW

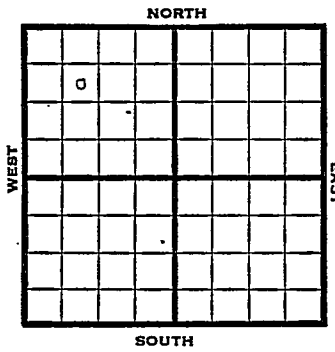

1948	Elev. 1834' REPORT
11/10	Location
11/16	"
11/23	RUR
11/30	8"@ 766'
12/8	Lansing 3090' Drlg 3192' -
12/15	Arb. 3320-26' TD 3326' 5"@ 3321 SSO
12/22	TD 3331 1000 acid
12/29	TD 3335 10 qts 3326-33 1000 acid CO
1949	
1/5	Arb. 3320' 5" @ 3321' TD 3335' ABANDONED

Form 26 200 Bks. 9-48 Petrol
Kansas

Yeakley Pool

Map No. ____ Sec. 17 Twp. 18 R. 13W

Well No. 2 Yeakley

Sohio etal. Company

FIRST REPORT Contractor

SE NW NW


990 Ft. from N. Line

____ Ft. from S. Line

____ Ft. from E. Line

990 Ft. from W. Line

SECTION PLAT

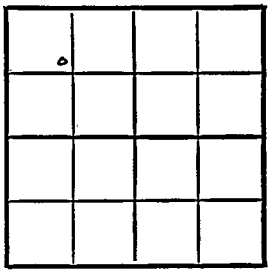

Barton County

Location x

Rig up

Drilling and Remarks:

RECORD

Cased ____ in., ____ ft.

Sand

Gas

Oil

Total Depth

PRODUCTION

1st 24 hrs. Nat.

1st 24 hrs. after shot

Gas ____ Cu. Ft.

Dry Hole

Abandoned

Date

NOV 10 1948 19 S. J. LEWIS Scout

Form 26 200 Bks. 9-48 Petrol

Yeakley Pool

Kansas

Map No. 13 Sec. 17 Twp. 18 R. 13W

Well No. 2 Yeakley


Sohio etal. Company

ABANDONED Contractor

SE NW NW

El. 1834

SECTION PLAT

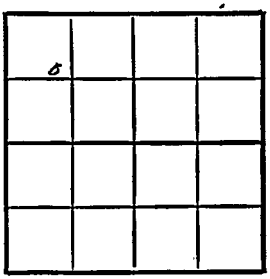

990 Ft. from N. Line

Ft. from S. Line

Ft. from E. Line

990 Ft. from W. Line

Barton County

Location

Rig up

Drilling and Remarks:

Cr 3320

5" @ 3321

RECORD

Cased in., ft.

Sand

Gas

Oil

Total Depth 3335

PRODUCTION

1st 24 hrs. Nat.

1st 24 hrs. after shot

Gas Cu. Ft.

Dry Hole

Abandoned

Date

JAN 5 1949 19 S. J. LEWIS Scout