

Sedgwick

KANSAS


SECTION 12 TOWNSHIP 26S RANGE ~~#~~ 2E

WELL NO. #4 DeMoss

COMPANY Raymond Oil Co.

NORTH

S/2 NW NW

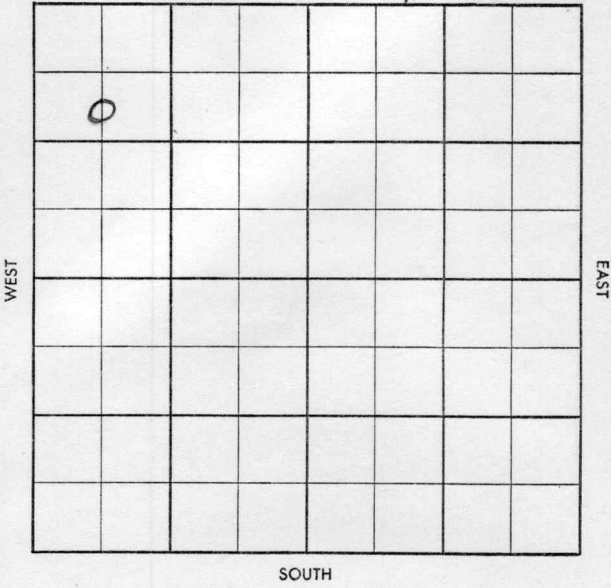



Twp. ~~\_\_\_\_\_~~ Pool ~~\_\_\_\_\_~~  
 Co. ~~\_\_\_\_\_~~ Facet ~~\_\_\_\_\_~~

S-513-B

County Sedgwick Elev. 1331 DF 1334 RB  
 Sec. 12 Twp. 26 Rge. 2E  
 Company Raymond Oil Co.  
 Farm Name DeMoss No. 4

TOPS	DEPTH	LOG	DATUM
Anh.			
Tp.			
H.			
Tr.			
Dg.			
B.L.			
L.			
K.C.	<u>2127</u>		
B.K.C.	<u>2346</u>		
Ce.	<u>2309</u>		
C.	<u>52 2757</u>		
M.	<u>Chat 2921</u>		
M.			
K.			
Mz.			
Mq.			
V.			
S.			
S.			
A.			
R.			
Pf.			
G.			
T.D.	<u>2825</u> <del>2450</del>		

Loc. in Sec. S/2 NW NW  
 Geol. \_\_\_\_\_  
 Contr. \_\_\_\_\_  
 Pool \_\_\_\_\_  
Greenwich  
 JUN 3 '58  
 COMPLETE

Date Comm. 5-8-58 9" 163/150  
 Location APR 30 '58 MAY 7 '58 MAY 14 '58 42640  
MAY 21 '58 ~~5" 2819/150~~ 4/50 WOCT MAY 28 '58

5" 2819/150 DD 2827 1/2 TD  
\$ FU 300' oil NW 2 hrs  
SD 48 hrs FU 1600' oil  
NW TOR JUN 3 '58

P25B0 pd NW  
\$

Co.  
 Sec.  
 No.  
 No.  
 Sec.  
 T.  
 R.