


KANSAS

Section 18- Township 18S Range 13W

Well No. #2 Jilg

Company Eldorado Ref. Co.

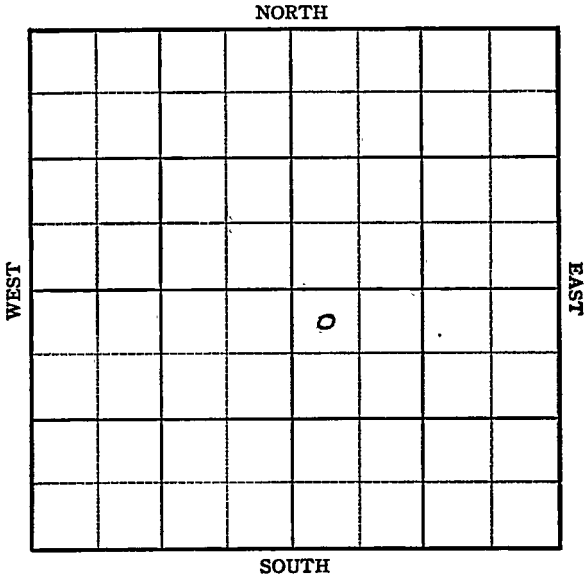

Barton

Sec. 18 Twp. 18 R. 13W

Well No. #2 Jilg Farm

Eldorado Ref.


Wildcat (Williams, Cont.) Company

330' Ft. from N. Line

_____ Ft. from S. Line

_____ Ft. from E. Line

330' Ft. from W. Line

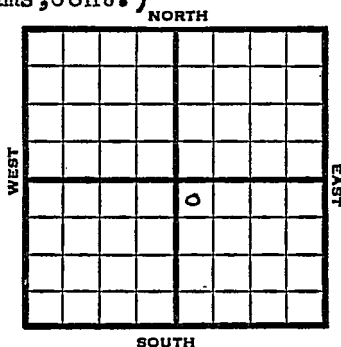

NW SE

1949

Elev. 1853' REPORT

9/14

Anhy 770'
8" @ 775'

9/28

Arb. 3336'
5" @ 3338'
TD 3349'
1750 acid

9/21

Lansing 3111'
Drlg. 3315'

9/28
10/5

Arb. 3336'
TD 3375'
Abd.

ABANDONED

Map No. _____ Sec. 18 Twp. 18 R. 13W

Well No. 2 Jilg

Eldorado Ref. _____ Company

Williams _____ Contractor

NW SE

SECTION PLAT

330 Ft. from N. Line

_____ Ft. from S. Line

_____ Ft. from E. Line

330 Ft. from W. Line

		△	

Barton County

Location _____

Rig up _____

Drilling and Remarks:

Anhy 770

8" @ 775

RECORD

Cased _____ in., _____ ft.

Sand _____

Gas _____

Oil _____

Total Depth _____

PRODUCTION

1st 24 hrs. Nat. _____

1st 24 hrs. after shot _____

Gas _____ Cu. Ft.

Dry Hole _____

Abandoned _____

Date

Map No. _____ Sec. 18 Twp. 18 R. 13W

Well No. 2 Jilg

Eldorado Ref. _____ Company

ABANDONED

Contractor

NW SE

E 1,1833
SECTION PLAT

330 Ft. from N. Line

_____ Ft. from S. Line

_____ Ft. from E. Line

330 Ft. from W. Line

		o	

Barton County

Location _____

Rig up _____

Drilling and Remarks:

Ar 83336.

RECORD

Cased _____ in., _____ ft.

Sand _____

Gas _____

Oil _____

Total Depth *2275*

PRODUCTION

1st 24 hrs. Nat. _____

1st 24 hrs. after shot _____

Gas _____ Cu. Ft.

Dry Hole _____

Abandoned _____

Date

OCT 5 1949 19

S I I FWIS Scout