


Sedgwick

KANSAS

SECTION 12 TOWNSHIP 26 RANGE 2E

WELL NO. #2 Lygrisse

COMPANY Buckendahl & Gould

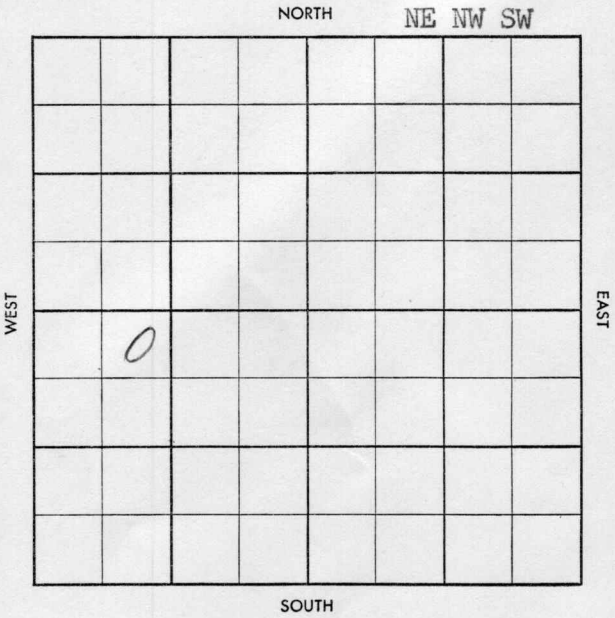

~~29~~

Our records show a #2 comp. well here. Could this be twin or workover? Please advise

County Sedgwick Elev. 1353
 Sec. 12 Twp. 26 Rge. 2E
 Company Buckendahl & Gould
 Farm Name Lygrisse No. 2

| TOPS | DEPTH | LOG | DATUM |
|--------|-------|-----|-------|
| Anh. | | | |
| Tp. | | | |
| H. | | | |
| Tr. | | | |
| Dg. | | | |
| BL. | | | |
| L. | | | |
| K.C. | 2375 | | |
| B.K.C. | 2540 | | |
| Ce. | | | |
| C. | 2806 | | |
| M. | 2814 | | |
| M. | 2825 | | |
| K. | | | |
| Mz. | | | |
| Me. | | | |
| V. | | | |
| S. | | | |
| S. | | | |
| A. | | | |
| R. | | | |
| PE. | | | |
| G. | | | |
| T.D. | 2856 | | |

Loc. in Sec. NE NW SW
 Geol. _____
 Contr. Winne
 Pool _____
Greenwich

FIRST REPORT
 SEP 11 1957

Date Comm. 8-30-57
8" @ 200/175 4" @ 2852/100 WOCT

Co.
 Lse.
 No.
 Sec.
 T.
 R.

Our records show a #2 comp. well here.
 Could this be twin or workover?
 Please advise.

FORM 513 SURVAY

| | | | | |
|-----|------|------|-----------|---------|
| Co. | 1353 | Elev | Thanks | County |
| | SE | Rgs. | IS | Sec. |
| | | | Sam Baird | Company |
| | | | | Farm |
| | | | | And |
| | | | | Tr. |
| | | | | H. |
| | | | | D. |
| | | | | Bl. |
| | | | | L. |
| | | | | K.C. |
| | | | | B.K.C. |
| | | | | Ce. |
| | | | | C. |
| | | | | M. |
| | | | | M. |
| | | | | K. |
| | | | | Mz. |
| | | | | Mg. |
| | | | | V. |
| | | | | S. |
| | | | | S. |
| | | | | A. |
| | | | | R. |
| | | | | Pe. |
| | | | | G. |
| | | | | Tr. |

*According to Scout
 check - this is a
 new well.*

FIRST REPORT
 SEP 17 1951

Date Comm. 8-30-51

8" @ 200/175 1" @ 285/100 WOCT

Co. Sec. T. R.

new well

FORM 513 SUNRAY

County Sedgwick Elev. 1353
 Sec. 12 Twp. 26 Rge. 2E
 Company Buckendahl & Gould
 Farm Name Lygrisse No. 2

| TOPS | DEPTH | LOG | DATUM |
|--------|-------|-----|-------|
| Anh. | | | |
| Tp. | | | |
| H. | | | |
| Tr. | | | |
| Dg. | | | |
| Bl. | | | |
| L. | | | |
| K.C. | 2375 | | |
| B.K.C. | 2540 | | |
| Ce. | 2806 | | |
| C. | 2811 | | |
| M. | 2825 | | |
| M. | | | |
| K. | | | |
| Mz. | | | |
| Ma. | | | |
| V. | | | |
| S. | | | |
| S. | | | |
| A. | | | |
| R. | | | |
| Pe. | | | |
| G. | | | |
| T.D. | 2856 | | |

Loc. in Sec. NE NW SW
 Geol. _____
 Contr. Winne
 Pool Greenwich

| | |
|-----------------|--|
| COMPLETE | |
| 0 | |
| SEP 25 '57 | |

Date Comm. 8-30-57

8" @ 200/175 4" @ 2852/100 WUCT

SEP 18 '57 PD 2857 \$ 4 B Pld
ph 15% oil 2d/2847-52
no incr water frac \$ Ld
SEP 25 '57 POP

15 Bopd 15% w

Co.
Lse.
No.
Sec.
T.
R.