


Section 20 Township 18 Range 13 W

Well No. # 1 Spitzmiller

Company J. H. Tallock

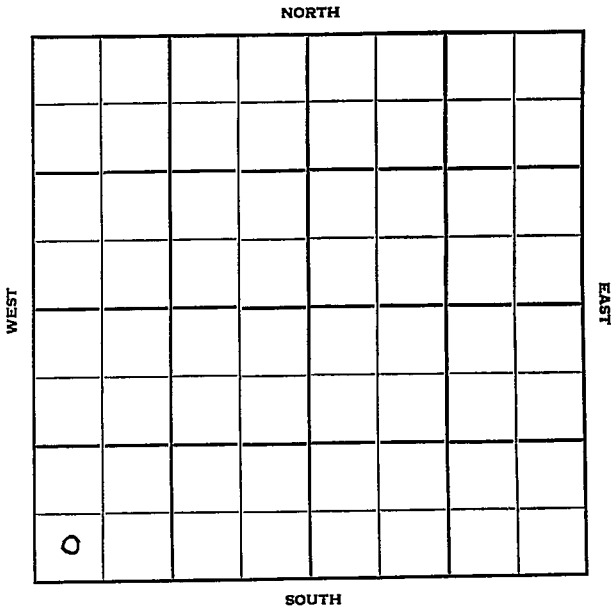

Barton

KANSAS

Sec. 20 Twp. 18 R. 13 W ✓

Well No. # 1 Spitzmiller Farm

J. H. Tatlock Company

Contractor

Wildcat

_____ Ft. from N. Line


330 Ft. from S. Line

_____ Ft. from E. Line

330 Ft. from W. Line

SW-SW SW

Sinclair DHM

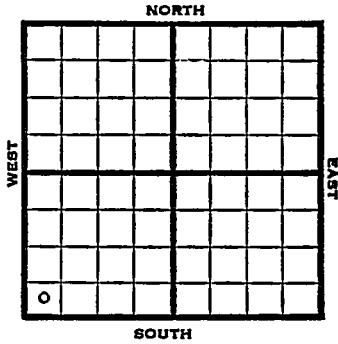

1951

Elev. 1903'

REPORT

5/23

Location

6/13

Spud 6-3-51

D & A TD 3456' 10" @ 822

Anhy 842' Br. lime 3157' KC 3175'

Cong. 3410' Arb. 3428'

TD 3456' D & A

ABANDONED

