

KANSAS

Barton



Sec. 18 Twp. 18 R. 13W

Well No. #2 Niblo Farm

Magnolia Company

Eveleigh Pool


330' Ft. from N. Line

_____ Ft. from S. Line

_____ Ft. from E. Line

990' Ft. from W. Line

NE NW NE

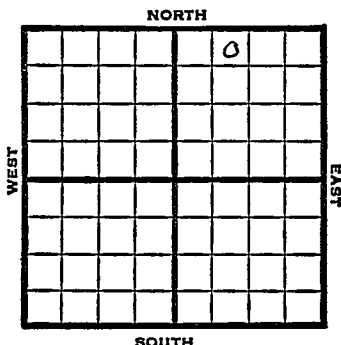

1949 elev 1854' REPORT

- 5/11 RUR
- 5/18 8" @ 792'
Drlg 1835'
- 5/25 Lans. 3107'
Arb. 3327-30'
TD 3330'
5" @ 3328'
- 6/1 "
- 6/8 Arb. 3327'
5" @ 3328'
TD 3351'
500 acid
Pump 106 Oil Pot
36° Gr.
Comp

COMPLETED

Map No. _____ Sec. 18 Twp. 18 R. 13W

Well No. 2 Niblo

Magnolia Company

Barnett Drlg. Contractor

FIRST REPORT
SECTION PLAT

NE NW NE

330 Ft. from N. Line

_____ Ft. from S. Line

_____ Ft. from E. Line

990 Ft. from W. Line

		o	

Barton County

Location _____

Rig up _____

Drilling and Remarks:

R U R

RECORD

Cased _____ in., _____ ft.

Sand _____

Gas _____

Oil _____

Total Depth _____

PRODUCTION

1st 24 hrs. Nat. _____

1st 24 hrs. after shot _____

Gas _____ Cu. Ft.

Dry Hole _____

Abandoned _____

Date

MAY 11 1949

19

S. J. LEWIS

Scout

Barton County Kansas State
 Map No. K 73 Sec. 18 Twp. 18 R. 13W

Well No. 2 Niblo

Magnolia Company

COMPLETE

NE NW NE Contractor

E. 1834

SECTION PLAT

330 Ft. from N. Line

_____ Ft. from S. Line

_____ Ft. from E. Line

990 Ft. from W. Line

Eveleigh Pool

Remarks:

Cr 83327

5" C 83328

ND 8351

500 acid

Prod 106 oil Bd

06 2/2

Date

JUN 8 1949

Scout

S. J. LEWIS