


KANSAS

Barton

Section 21 Township 18N Range 13WWell No. #1 TresterCompany Texas

NORTH

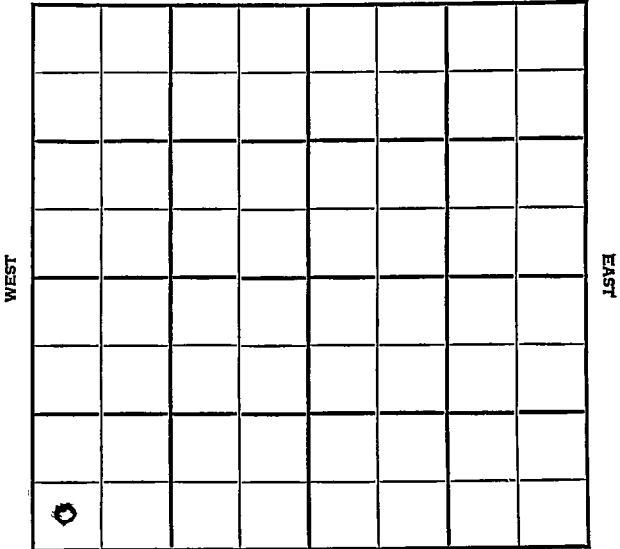

SOUTH

KANSAS


Barton

Sec. 21 Twp. 18 R. 13WWell No. #1 Trester Farm\ Texas Company

Wildcat

 Ft. from N. Line330' Ft. from S. Line Ft. from E. Line330' Ft. from W. Line

SW/C

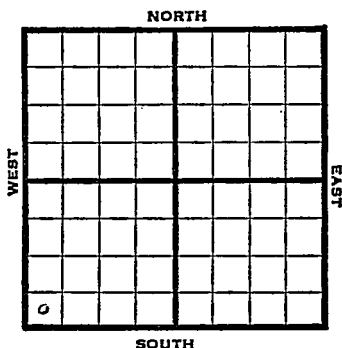

1948

Eli 1870'

REPORT

6/9 Surface Hole

6/16 10" @ 797'
Drlg. 2715'

6/23 Lansing 3135'
Arbuckle 3368
TD 3375'
8" @ 3372'
RUST

6/29 48 shots 3371-75
CO

7/8 TD 3389' 2000 acid
swb 3½ bbls oil PB

7/14 Pump 74 bbls oil / 10 W 18 hrs.

7/21 TD 3389'
Arb. 3368'
7" @ 3372'
Perf Arb. 2000 acid
Pump 28 Oil / 3 W Pot
32° Gr.
Comp.

COMPLETED

Map No. _____ Sec. 21 Twp. 18 R. 13W

Well No. 1 Trester

_____ Texas _____ Company

FIRST REPORT

_____ Contractor

SW/C

SECTION PLAT

_____ Ft. from N. Line

330 Ft. from S. Line

_____ Ft. from E. Line

330 Ft. from W. Line

Barton County

Location _____

Rig up _____

Drilling and Remarks:

surface hole

RECORD

Cased _____ in., _____ ft.

Sand _____

Gas _____

Oil _____

Total Depth _____

PRODUCTION

1st 24 hrs. Nat. _____

1st 24 hrs. after shot _____

Gas _____ Cu. Ft.

Dry Hole _____

Abandoned _____

Date

JUN 9 1948

19

S. J. LEWIS

Scout

Map No. 73 Sec. 21 Twp. 18 R. 13WWell No. 1 Trester

Texas

Company


COMPLETE

Contractor

SW/C

E11870

SECTION PLAT

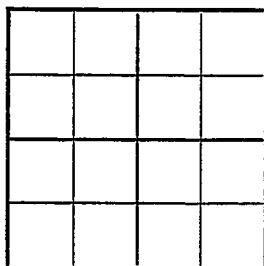 Ft. from N. Line330 Ft. from S. Line Ft. from E. Line330 Ft. from W. Line

Barton County

Location Rig up

Drilling and Remarks:

*Cur 3368**7" @ 3372**Perf art.**2000 and**Pump 28 oil + 3W**Per 32 2/4*

RECORD

Cased in., ft.Sand Gas Oil ✓Total Depth 3389

PRODUCTION

1st 24 hrs. Nat. 1st 24 hrs. after shot Gas Cu. Ft.Dry Hole Abandoned

Date

JUL 21 1948

19

S. J. LEWIS

Scout