


Section 22 Township 18 Range 13 WWell No. #2 EveleighCompany ~~N. C. H. A.~~ Raymond Geor et al

NORTH

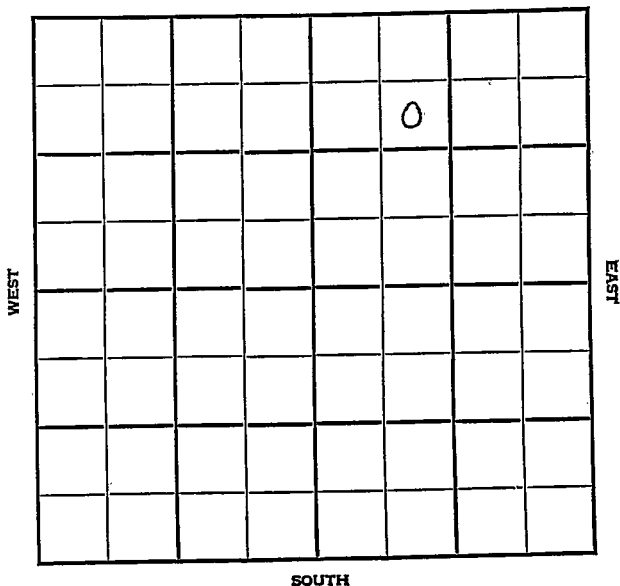

KANSAS

Barton

Sec. 22 Twp. 18 R. 13WWell No. #2 Eveleigh Farm
Raymond Gear et al
N.C.R.A. Company

Eveleigh


990' Ft. from N. Line

Ft. from S. Line

Ft. from E. Line

990' Ft. from W. Line

SE NW NE

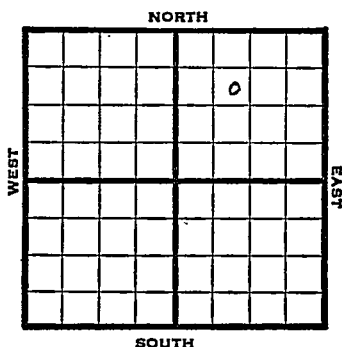

1948 Eli 1808' REPORT

7/14 8" @ 540'
Anhy. 710'
Drlg. 1740'

7/21 Lansing 3075'
Arb. 3325'
TD 3331'
5" @ 3326'

7/28 "

8/4 TD 3348' PB 3319'
1000 acid
Pump 95 bbls. fluid 10 hrs. 75% oil.

8/11 "

8/18 Arb. 3325'
5" @ 3326'
TD 3356'
Aband.

ABANDONED

Map No. _____ Sec. 22 _____ Twp. 18 _____ R. 13W

Well No. 2 Eveleigh

N. C. R. A.

Company

FIRST REPORT

Contractor

SE NW NE

SECTION PLAT

990 Ft. from N. Line

		o	

Ft. from S. Line

Ft. from E. Line

990 Ft. from W. Line

Barton County

Location

Rig up

Drilling and Remarks:

8" @ 540

anhy 710

Drig. 1740

RECORD

Cased _____ in., _____ ft.

Sand

Gas

Oil

Total Depth

PRODUCTION

1st 24 hrs. Nat. _____

1st 24 hrs. after shot _____

Gas _____ Cu. Ft.

Dry Hole _____

Abandoned _____

Date

JUL 14 1948

19

S. J. LEWIS

Scout

Map No. 73 Sec. 22 Twp. 18 R. 13W

Well No. 2 Eveleigh

Raymond Gear et al. Company

CORRECTION

Contractor

SE NW NE

SECTION PLAT

990 Ft. from N. Line

 Ft. from S. Line

 Ft. from E. Line

990 Ft. from W. Line

		o	

Barton County

Location

Rig up

Drilling and Remarks:

Reported
as N C R A

RECORD

Cased in., ft.

Sand

Gas

Oil

Total Depth

PRODUCTION

1st 24 hrs. Nat.

1st 24 hrs. after shot

Gas Cu. Ft.

Dry Hole

Abandoned

Date

JUL 21 1948 19 S. J. LEWIS Scout

Barton County Kansas StateMap No. 73 Sec. 22 Twp. 18 R. 13WWell No. 2 EveleighRaymond Gear et al. Company**ABANDONED**

Contractor

SE NW NE

E. 11/18/08
SECTION PLAT

990 Ft. from N. Line Ft. from S. Line Ft. from E. Line990 Ft. from W. LineEveleigh Pool

Remarks:

*Oil 3325-**5' 103326**7753356*Date
AUG 18 1948Scout
S. J. LEWIS