
FORM 51 25M 3-49 PETROL KANSAS Sedgwick

Section 13 Township 26 Range 2-E

Well No. #2 Pettijean (Petitjean)

Company J P Gatty

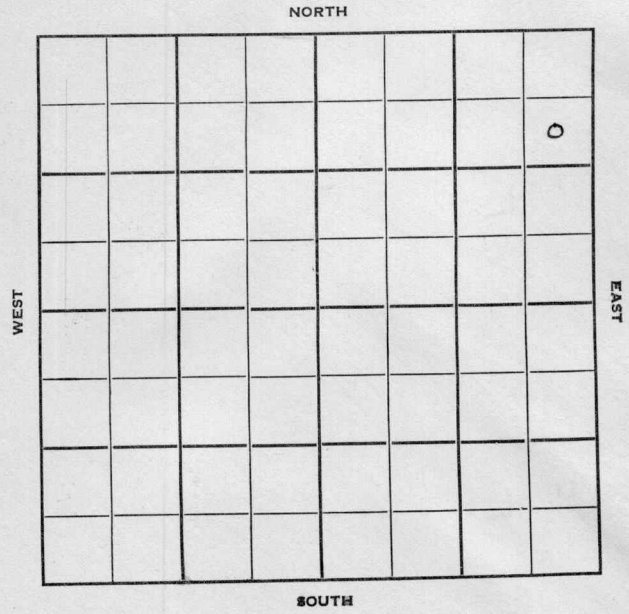

FORM 252-B
10M 9-49 PETROL

KANSAS Sedgwick

Sec. 13 Twp. 26 R. 2-E

Well No. #2 Pettijean Farm

J P Gatty Company

Contractor

Miscellaneous


990 Ft. from N. Line

Ft. from S. Line

330 Ft. from E. Line

Ft. from W. Line

SE NE NE

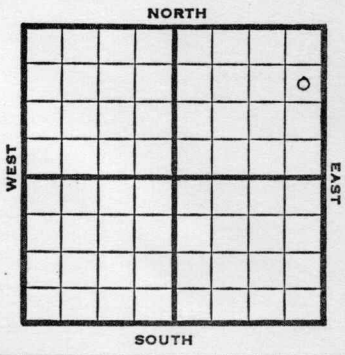

1950	Elev. 1362' REPORT
7/26	Location
9/13	Oil Well TD 2859' 8" @ 100' Miss 2812-44' 5" @ 2843' SO 2856' TD 2859' Comp. 40 BOPD 7 BW COMPLETED

Form 26 200 Bks. 11-49 Petrol

Kansas

Map No. _____ Sec. 13 Twp. 26 R. 2E

Well No. 2 Pettijean

J. P. Gatty Company

Contractor

SE NE NE

990 Ft. from N. Line

Ft. from S. Line

330 Ft. from E. Line

Ft. from W. Line

Sedgwick County

SECTION PLAT



Location x

Rig up

Drilling and Remarks:

RECORD

Cased in., ft.

Sand

Gas

Oil

Total Depth

PRODUCTION

1st 24 hrs. Nat.

1st 24 hrs. after shot

Gas Cu. Ft.

Dry Hole

Abandoned

Date

JUL 26 1950 19

J. E. TYRA Scout

FORM 275 FOR SALE BY KANSAS BLUE PRINT CO.


County Sedgwick State Kansas

Sec. 13 (Blk. Twp.) 26 (Sur. Rge.) 2E Map No.

Operator J. P. Gatty

Well No. 2 Farm Pettijean

Elev. 1362 Location SE NE NE

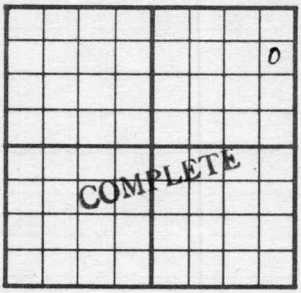

990 Ft. From N Line NE

330 Ft. From E Line Quarter

1st. Report

Completion SEP 1 3 1950

Remarks

Miscellaneous

Spudding Date

Drlg. Data Oil well TD 2859

8" @ 100 Miss. 2812-44 5" @ 2843

SO 2856-59 TD Comp. 40 bopd 7 bw

J. E. TYRA