

KANSAS

FORM 51 25M 3-49 PETROL

Sedgwick

Section 13 Township 26 Range 2-E

Well No. #3 Pettijean (*Petitjean*)

Company J P Gatty

NORTH

WEST

EAST

						0	

SOUTH

Sec. 13 Twp. 26 R. 2E

Well No. #3 Pettijean Farm

J. P. Gatty Company

Contractor

Botwick Pool


 Ft. from N. Line

990' Ft. from S. Line

990' Ft. from E. Line

 Ft. from W. Line

NW SE NE

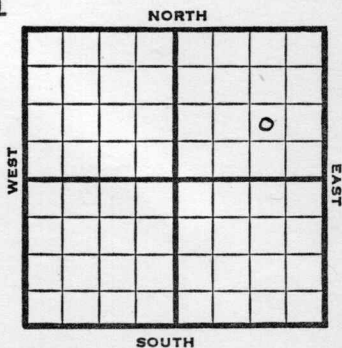

1950

Elev 1360

REPORT

9/20

Location

10/25

Spud 10-6-50

8" @ 75

Miss 2809

TD 2856

5½" @ 2835

TD 2856

D&A

ABANDONED

County Sedwick State Kansas

Sec. 13 (Blk. 26) (Sur. 25) (Rge. 25) Map No.

Operator J. P. Gatty

Well No. 3 Farm Pettigean

Elev.	Location	NW	SE	NE

[illegible]

990 Ft. From S Line NE

	Ft. From	E	Line	Quarter
990				

1st. Report SEP 20 1950

Completion


Remarks

Spudding Date _____

Drlg. Data Returick Pool

Location

J. E. TYRA

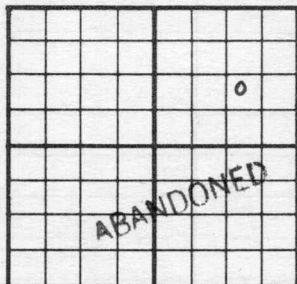County Sedgwick State KansasSec. 13 (Blk.) 26 (Sur.) 2E Map No.Operator J. P. GattyWell No. 3 Farm PettijeanElev. 1360 Location NW SE NE990 Ft. From S Line NE990 Ft. From E Line Quarter

1st. Report

Completion OCT 25 1950Remarks Botwick PoolSpudding Date 10-6-50Drlg. Data D & A TD 28568" @ 75 Miss. 2809 TD 2856 5 $\frac{1}{2}$ " @ 2835D & A

J. E. TYRA