


KANSAS

Section 22 Township 18 Range 13WWell No. 1-SMITH HALLCompany Palmer Oil

Homestead Pool

NORTH

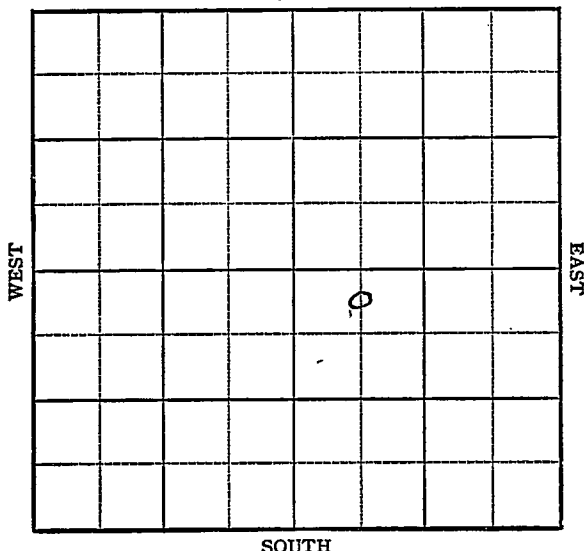

KANSAS Barton ✓

Sec. 22 Twp. 18 R. 13-W ✓

Well No. #1 Smith Hall Farm

Palmer Oil Company

Homestead Pool


330 Ft. from N. Line

 Ft. from S. Line

 Ft. from E. Line

660 Ft. from W. Line

C N L NW SE

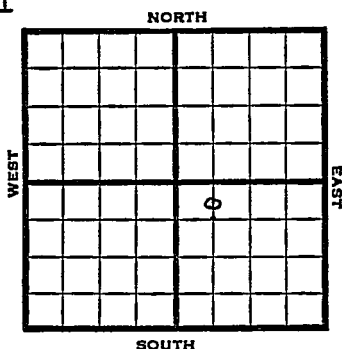

1948

Elev. 1805' REPORT

12/22

8 5/8" @ 540'

Anhy 800'

Drlg 1491'

12/29

1949

1/5

Lans. 3098'

Arb. 3326'

TD 3350'

ABANDONED

Map No. _____ Sec. 22 Twp. 18 R. 13W

Well No. 1 Smith


Palmer Oil Company

FIRST REPORT

Contractor

C N L NW SE

SECTION PLAT

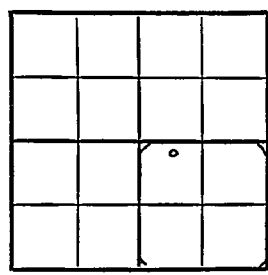

330 Ft. from N. Line

_____ Ft. from S. Line

_____ Ft. from E. Line

660 Ft. from W. Line

Barton County

Location _____

Rig up _____

Drilling and Remarks:

8 5/8" @ 540

Anhy 800

drlg. 1491

RECORD

Cased _____ in., _____ ft.

Sand _____

Gas _____

Oil _____

Total Depth _____

PRODUCTION

1st 24 hrs. Nat. _____

1st 24 hrs. after shot _____

Gas _____ Cu. Ft.

Dry Hole _____

Abandoned _____

Date

DEC 22 1948 19 S. J. LEWIS Scout

Map No. 73 Sec. 22 Twp. 18 R. 13W

Well No. 1 Hall

Palmer Oil

Company

CORRECTION

Contractor

C N L NW SE


SECTION PLAT

330 Ft. from N. Line

 Ft. from S. Line

 Ft. from E. Line

660 Ft. from W. Line

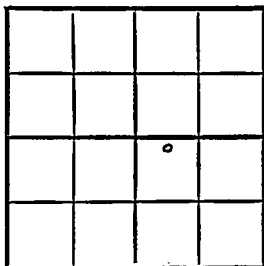

Barton County

Location

Rig up

Drilling and Remarks:

Reported

#1 Smith

RECORD

Cased in., ft.

Sand

Gas

Oil

Total Depth

PRODUCTION

1st 24 hrs. Nat.

1st 24 hrs. after shot

Gas Cu. Ft.

Dry Hole

Abandoned

Date

DEC 29 1948 19 S. J. LEWIS Scout

Map No. 73 Sec. 22 Twp. 18 R. 13W

Well No. 1 Hall

Palmer Oil

Company

ABANDONED

Contractor

C N L NW SE


E. 1, 1825.
SECTION PLAT

330 Ft. from N. Line

 Ft. from S. Line

 Ft. from E. Line

660 Ft. from W. Line

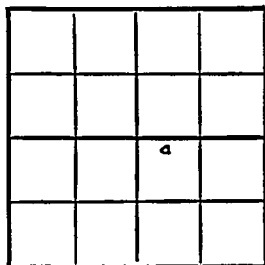

Barton County

Location

Rig up

Drilling and Remarks:

Lane 3078
Cr. 3326

RECORD

Cased in., ft.

Sand

Gas

Oil

Total Depth 3350

PRODUCTION

1st 24 hrs. Nat.

1st 24 hrs. after shot

Gas Cu. Ft.

Dry Hole

Abandoned

Date

JAN 5 1949 19

S. J. LEWIS

Scout