


Map No. **KANSAS** Sec. **26** Twp. **18** R. **13<sup>w</sup>**

Well No. **1-Smith** Farm \_\_\_\_\_  
**Lario O & H** Company \_\_\_\_\_

NORTH

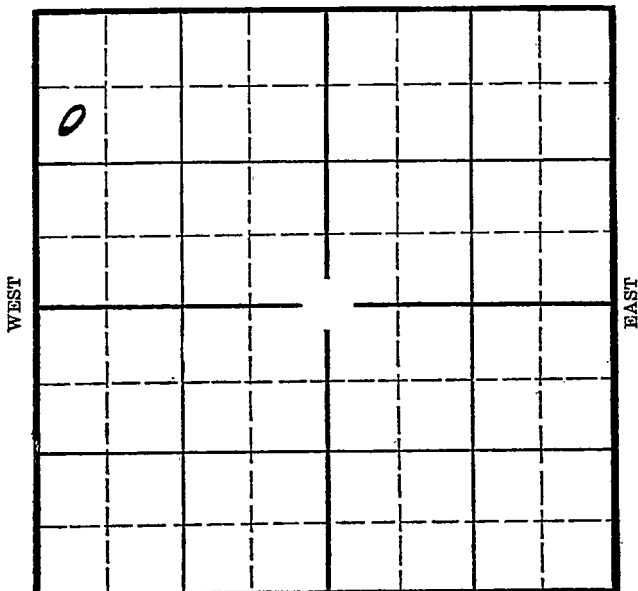

SOUTH

Location \_\_\_\_\_  
Drilling Remarks \_\_\_\_\_

Rig Up \_\_\_\_\_  
Drilling Remarks \_\_\_\_\_

\_\_\_\_\_  
 \_\_\_\_\_  
RECORD

PRODUCTION

Cased \_\_\_\_\_ in. \_\_\_\_\_ ft.  
 Sand \_\_\_\_\_  
 Gas \_\_\_\_\_  
 Oil \_\_\_\_\_  
 Total Depth \_\_\_\_\_


1st 24 hrs. Nat. \_\_\_\_\_  
 1st 24 hrs. after shot \_\_\_\_\_  
 Gas \_\_\_\_\_ cu. ft. \_\_\_\_\_  
 Dry Hole \_\_\_\_\_  
 Abandoned \_\_\_\_\_

Barton  
26 18 13<sup>W</sup>

Map No.            Sec. 26 Twp. 18 R. 13<sup>W</sup>

Well No. 1-Smith Farm             
Lario O & H Company           

990 Ft. from N. Line  
           Ft. from S. Line  
           Ft. from E. Line  
330 Ft. from W. Line  
Elev. 1805

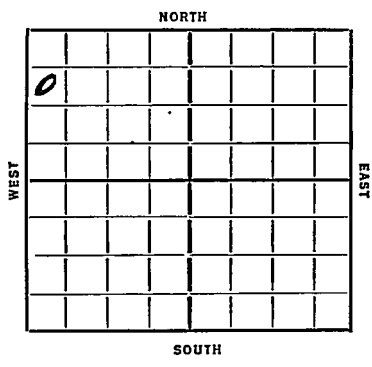

Date	REPORT
1935	
9/25	Cellar
10/3	— 10/10
11/1	Alg 225 20" 121
11/7	15" 248 TD 705 SD for pipe
11/14	Alg 850 17" 693
11/21	" 1775
11/29	TD 2070 10" collapsed
	Tools froze jarring on tools
12/6	10" 2065 TD 2106 seg
12/13	10" 2100 WOC
12/19	Alg 2285
12/26	—
1/3/36	Alg 3050
1/8	Alg 3318
	TD 3364 HF W
	DTA.

ABANDONED

Map No. 73 Sec. 26 Twp. 18 R. 13

Well No. 1 - Smith

Lario O + M. Company

Contractor

FIRST REPORTS

SECTION PLAT

990 Ft. from N. Line

..... Ft. from S. Line

..... Ft. from E. Line

330 Ft. from W. Line

0			

Location.....

Rig up.....

Drilling and Remarks:

*cellar*

RECORD

Cased..... in., ..... ft.

Sand.....

Gas.....

Oil.....

Total Depth.....

PRODUCTION

1st 24 hrs. Nat.....

1st 24 hrs. after shot.....

Gas..... Cu. Ft.

Dry Hole.....

Abandoned.....

Date

9-25-35

Scout

Map No. 73 Sec. 26 Twp. 18 R. 13W

Well No. 1 - Smith

Lario Oil & Gas Company

Contractor

**SECTION PLAT**

990 Ft. from N. Line

..... Ft. from S. Line

..... Ft. from E. Line

330 Ft. from W. Line

0			

**COMPLETED**

Location.....

Rig up.....

Drilling and Remarks:

*hfw.*

*D & A.*

**RECORD**

Cased..... in., ..... ft.

Sand *Sil* 3318

Gas.....

Oil.....

Total Depth 3364

**PRODUCTION**

1st 24 hrs. Nat.....

1st 24 hrs. after shot.....

Gas..... Cu. Ft.

Dry Hole.....

Abandoned.....

Date

**JAN 8 1936**

**ORVAL MANNSCHRECK**

192.....

Scout