


KANSAS Barton

Section 28 Township 18 Range 13-W

Well No. #1 Smith

Company Ben Brack
Lake Barton Pool

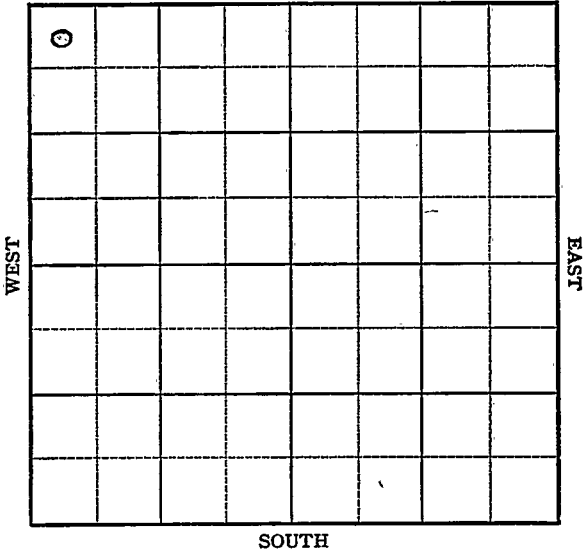

Sec. 28 Twp. 18 R. 13W

Well No. 1 Smith Farm

Ben Brack Company

Lake Barton Pool


330 Ft. from N. Line

_____ Ft. from S. Line

_____ Ft. from E. Line

330 Ft. from W. Line

NW/C

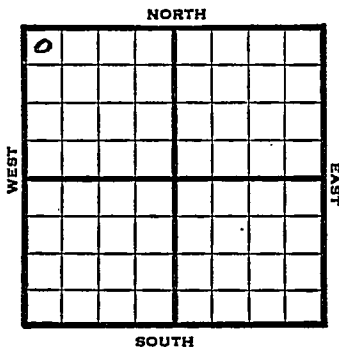

1949

Elev 1885'

REPORT

8/24

8" @ 465
Anhy 965
Drlg 1700

8/31

Drlg. 3311'

9/7

Lansing 3164'
Arbuckle 3400'
5" @ 340'
TD 3310' wtr
PB 3408'

9/14

"

9/21

Swb 18 bbls oil a day

9/28

"

10/5

"

10/12

"

10/19

TD 3410'
Arb. 3400'
Aband.

ABANDONED

Kansas

Map No. _____ Sec. 28 Twp. 18 R. 13W

Well No. 1 Smith

Ben Brack _____ Company

FIRST REPORT Contractor

NW/C

SECTION PLAT

330 Ft. from N. Line

_____ Ft. from S. Line

_____ Ft. from E. Line

330 Ft. from W. Line

0			

Barton County

Location _____

Rig up _____

Drilling and Remarks:

8" C. 465

Anhy 965

drlg. 1700

RECORD

Cased _____ in., _____ ft.

Sand _____

Gas _____

Oil _____

Total Depth _____

PRODUCTION

1st 24 hrs. Nat. _____

1st 24 hrs. after shot _____

Gas _____ Cu. Ft.

Dry Hole _____

Abandoned _____

Date

AUG 24 1949 19

S. I. LEWIS Scout

Map No. _____ Sec. 28 Twp. 18 R. 13W

Well No. 1 Smith

Ben Brack _____ Company

ABANDONED

Contractor

NW/C

E. 1885
SECTION PLAT

330 Ft. from N. Line

_____ Ft. from S. Line

_____ Ft. from E. Line

330 Ft. from W. Line

o			

Barton County

Location _____

Rig up _____

Drilling and Remarks:

See 83400

RECORD

Cased _____ in., _____ ft.

Sand _____

Gas _____

Oil _____

Total Depth *3410*

PRODUCTION

1st 24 hrs. Nat. _____

1st 24 hrs. after shot _____

Gas _____ Cu. Ft.

Dry Hole _____

Abandoned _____

Date

OCT 19 1949

19

S. J. LEWIS

Scout