

*Sedgwick*  
14  
26 R. 2 E  
*W. Hamant*  
*Typos Oil*


Form 51-5M-2-29-34703

Map No. **KANSAS** Sec. \_\_\_\_\_ Twp. \_\_\_\_\_ R. \_\_\_\_\_

Well No. \_\_\_\_\_ Farm \_\_\_\_\_

\_\_\_\_\_ Company

NORTH

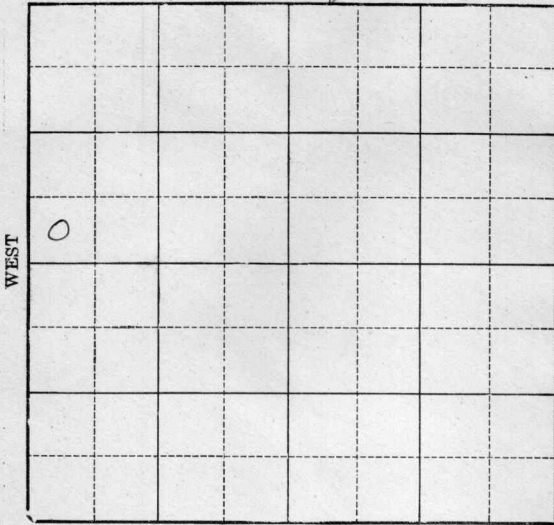

WEST

EAST

SOUTH

Location \_\_\_\_\_

Drilling Remarks \_\_\_\_\_

\_\_\_\_\_  
\_\_\_\_\_  
Rig Up \_\_\_\_\_

Drilling Remarks \_\_\_\_\_

\_\_\_\_\_  
\_\_\_\_\_  
**RECORD**

Cased \_\_\_\_\_ in. \_\_\_\_\_ ft.

Sand \_\_\_\_\_

Gas \_\_\_\_\_

Oil \_\_\_\_\_

Total Depth \_\_\_\_\_

**PRODUCTION**

1st 24 hrs. Nat. \_\_\_\_\_

1st 24 hrs. after shot \_\_\_\_\_

Gas \_\_\_\_\_ cu. ft.

Dry Hole \_\_\_\_\_

Abandoned \_\_\_\_\_

*Sedgwick*

Map No. KANSAS Sec. 14 Twp. 26 R. 2<sup>E</sup>

Well No. 1 - Hamant Farm


Gypsy Oil Company

\_\_\_\_\_ Ft. from N. Line

330 Ft. from S. Line

\_\_\_\_\_ Ft. from E. Line

330 Ft. from W. Line

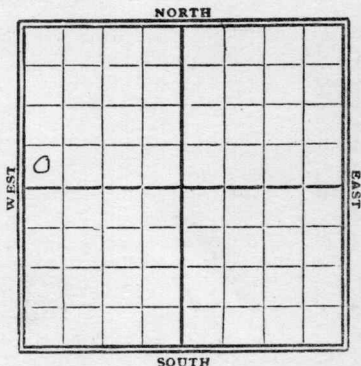

1929

Date

REPORT

4/24	Log
5/1	Rig
5/8	Went 500'
5/15	" 2590
5/22	8" - 3085
5/31	2 of pay 3163 - 66
	1st 24 hrs - 1776 bbl
6/5	sand 3163 - 66'
	T.D. 3166'
	swab 1776 bbls oil
	Comp

Map No. KANSAS Sec. 14 Twp. 26 R. 2E

Well No. 1 Haman

Gary Oil Company

Contractor

SECTION PLAT

..... Ft. from N. Line

330 Ft. from S. Line

..... Ft. from E. Line

330 Ft. from W. Line

0			

FIRST REPORTS

Location.....

Rig up.....

Drilling and Remarks:

ROG

RECORD

Cased..... in., ..... ft.

Sand.....

Gas.....

Oil.....

Total Depth.....

PRODUCTION

1st 24 hrs. Nat.....

1st 24 hrs. after shot.....

Gas..... Cu. Ft.

Dry Hole.....

Abandoned.....

Date

APR 24 1929

192.....

S. J. LEWIS

Scout

Map No. KANSAS Sec. 14 Twp. 26 R. 2E

Well No. 1 Haman

Sydney Oil Company

Contractor

SECTION PLAT


..... Ft. from N. Line

330 Ft. from S. Line

..... Ft. from E. Line

330 Ft. from W. Line

COMPLETED

Location.....

Rig up.....

Drilling and Remarks:

Sand 3163 &  
3166

Swatted 1776  
x/4.

RECORD

Cased..... in., ..... ft.

Sand.....

Gas.....

Oil.....

Total Depth 816.6

PRODUCTION

1st 24 hrs. Nat.....

1st 24 hrs. after shot.....

Gas..... Cu. Ft.

Dry Hole.....

Abandoned.....

Date

JUN 5 1929

S. J. LEWIS Scout