



Sec. 29 Twp. 18 R. 13


Well No. #1 Haberman Farm

Magnolia Company

Lake Barton Pool

NORTH

330' Ft. from N. Line

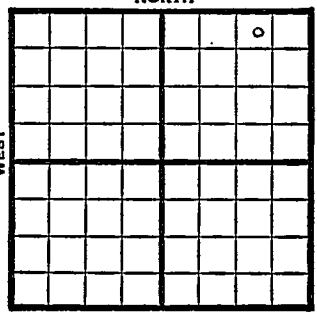

_____ Ft. from S. Line

890' Ft. from E. Line

_____ Ft. from W. Line

NW NE NE

SOUTH

1949 Elev 1849' REPORT

3/9 Location
 3/16 10" @ 935'
 Drlg 1150'

3/23 Drlg. 2935'
 3/30 Lansing 3124
 Arbuckle 3357-60'
 TD 3360'
 6" @ 3358'

4/6 TD 3371
 2500 acid
 swb 14 bbls oil / Water 14 hrs.
 PB 3367'

4/12 20 shes 3360-67
 4000 acid

4/20 Swb 3/4 bbls oil PH
 TD 3371'
 Arb 3357'
 6" @ 3358'
 4500 acid
 Pump 16 oil / 4 W Pot
 36° Gr.
 Comp

COMPLETED

Map No. _____ Sec. 29 Twp. 18 R. 13W

Well No. 1 Haberman

Magnolia Company

FIRST REPORT Contractor _____

NW NE NE

SECTION PLAT

330 Ft. from N. Line

_____ Ft. from S. Line

890 Ft. from E. Line

_____ Ft. from W. Line

			o

Barton County

Location X

Rig up _____

Drilling and Remarks:

RECORD

Cased _____ in., _____ ft.

Sand _____

Gas _____

Oil _____

Total Depth _____

PRODUCTION

1st 24 hrs. Nat. _____

1st 24 hrs. after shot _____

Gas _____ Cu. Ft.

Dry Hole _____

Abandoned _____

Date

MAR 9 1949 19

S. J. LEWIS Scout

Kansas

Map No. K73 Sec. 29 Twp. 18 R. 13WWell No. 1 HabermanMagnolia

Company

COMPLETE

Contractor

NW NE NE

E. 1874
SECTION PLAT330 Ft. from N. Line

_____ Ft. from S. Line

890 Ft. from E. Line

_____ Ft. from W. Line

Barton County

RECORD

Location _____

Cased _____ in., _____ ft.

Rig up _____

Sand _____

Drilling and Remarks:

Gas _____

Oil _____

Total Depth 3371

PRODUCTION

1st 24 hrs. Nat. _____

1st 24 hrs. after shot _____

Gas _____ Cu. Ft.

Dry Hole _____

Abandoned _____

Date

APR 20 1949 19

S. J. LEWIS Scout

*Dr 335.7
6" @ 335.7
4500 acid**Prod 16 oil + 4 WOB**36°/4*