

Cowley

KANSAS

SECTION 28 TOWNSHIP 30 RANGE 7E

WELL NO. #1 Smith "B"

COMPANY Marts Oil & Glick

NORTH

	0						

WEST

EAST

SOUTH

Cowley

KANSAS

SEC.

28

TWP.

30

R.

7E

WELL NO.

#1 Smith "B"

FARM

COMPANY

Marts Oil & Glick

CONTRACTOR

Co. Tools

Box Pool Ext.


____ FT. FROM N. LINE

____ FT. FROM S. LINE

____ FT. FROM E. LINE

____ FT. FROM W. LINE

SE NW SW

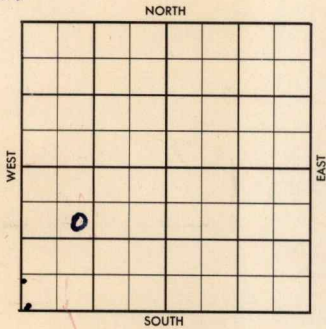

1956

ELEVATION

1422'

REPORT

5-23

MIR

5-29

Comm. 5-24-56

8 5/8" @60 w/50

6-6

D & A

6-13

No report

6-20

D & A

K. C. 2150', M. 2857', A. 3192',
TD 5200

ABANDONED

County Cowley Elev. _____
 Sec. 28 Twp. 30 Rge. 7E
 Company Marta Oil & Glick
 Farm Name Smith No. 1

TOPS	DEPTH	LOG	DATUM	Loc. in Sec.
Anh.				SE NW SW
Tr.				
H.				
Tr.				
Dg.				
B.L.				
L.				
K.C.				Geol. _____
B.K.C.				Contr. _____
Ce.				Co. tools _____
C.				
M.				Pool _____
M.				Box Pool Ext. _____
K.				
Mz.				
Mq.				
V.				
S.				
S.				
A.				
R.				
Pf.				
G.				
T.D.				

FIRST REPORT			
MAY 13 36			
0			

Date Comm. M I R

8281 P S YAM

R. G. R.

County Cowley Elev. 1422
 Sec. 28 Twp. 30 Rge. 7E
 Company Marts Oil & Glick
 Farm Name Smith "B" No. 1

TOPS	DEPTH	LOG	DATUM	Loc. in Sec.
Anh.				SE NW SW
Tr.				E 1/2 NW SW?
H.				
Tr.				
Dg.				900-WL
Bl.				400 St SW 1/4
L.				
K.C.	2150			Geol.
B.M.C.				Contr.
Ce.				Co. tools
C.				
M.	2857			Pool
M.				Box Pool Ext.
K.				
Mz.				
Mq.				
V.				
S.				
S.				ABANDONED
A.	3192			
R.				
Pe.				
G.				
T.D.	3200			

Date Comm. JUN '2 00 1956

M I R MAY 29 '56 5-24-56

85/8 60/50 D 2105 JUN 6 '56

D & A JUN 13 '56 JUN 20 '56

D & A