

Sedgwick
 Map No. KANSAS Sec. 14 Twp. 26 R. 2E
 Well No. 3-Hamant Farm
Trypsy Oil Company

NORTH

WEST

EAST

SOUTH

Location.....

Drilling Remarks

.....

.....

RECORD

Cased..... in..... ft.

Sand.....

Gas.....

Oil.....

Total Depth.....

Rig Up.....

Drilling Remarks

.....

.....

PRODUCTION

1st 24 hrs. Nat.....

1st 24 hrs. after shot.....


Gas..... cu. ft.....

Dry Hole.....

Abandoned.....

Sedgwick
 Map No. KANSAS Sec. 14 Twp. 26 R. 2^E
 Well No. 3 - Hamant Farm
Gypsy Oil Company

990 Ft. from N. Line
 _____ Ft. from S. Line
 _____ Ft. from E. Line
330
990 Ft. from W. Line

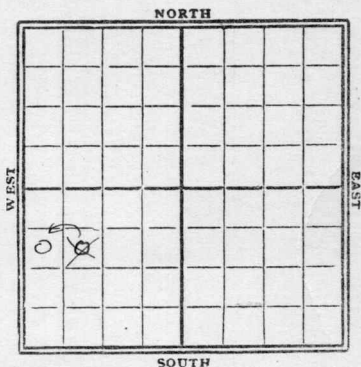

1929

Date

REPORT

5/22	Bldg Rig
5/29	109' sur. pipe
6/5	Per 9 1910'
6/12	" 2850'
6/19	8" 3130'
6/26	Simpson 3200-05 T.D. 3205' swab 180 bbls oil Comp.
1931	OWDD
5/27	Old T.D. 3205 R. U. to deepen
6/3	
6/10	Dreg 3244'
6/17	" 3315'
6/24	6"- 3315'
7/1	Land 3315-20 40 bbl show dreg 3321 (over)

7/8 Sand 3315-3327
115 bbls oil
(Comp)

Map No. KANSAS Sec. 14 Twp. 26 R. 2E

Well No. 8 Norman

Spring Oil Company

Contractor

SECTION PLAT

990 Ft. from N. Line

..... Ft. from S. Line

..... Ft. from E. Line

990 Ft. from W. Line

FIRST REPORTS

Location.....

Rig up.....

Drilling and Remarks:

Building rig

RECORD

Cased..... in., ... ft.

Sand.....

Gas.....

Oil.....

Total Depth.....

PRODUCTION

1st 24 hrs. Nat.....

1st 24 hrs. after shot.....

Gas..... Cu. Ft.

Dry Hole.....

Abandoned.....

Date

MAY 22 1929

192.....

S. J. LEWIS Scout

Map No. KANSAS Sec. 14 Twp. 26 R. 2E

Well No. 3 Mamant

Gypsy Oil Company

Contractor

SECTION PLAT

990 Ft. from N. Line

..... Ft. from S. Line

..... Ft. from E. Line

990 Ft. from W. Line

COMPLETED

Location.....

Rig up.....

Drilling and Remarks:

Simpson Canal

3200-05

Swashed 180 ft

RECORD

Cased.....in., ...ft.

Sand.....

Gas.....

Oil.....

Total Depth 3205

PRODUCTION

1st 24 hrs. Nat.....

1st 24 hrs. after shot.....

Gas.....Cu. Ft.

Dry Hole.....

Abandoned.....

Date


S. J. LEWIS Scout

Seaglowck

Map No. KANSAS Sec. 14 Twp. 26 R. 2
Well No. 3 R. Hamant
Gypsum Oil Co Company
Contractor

FIRST REPORTS

990 Ft. from N. Line
Ft. from S. Line
Ft. from E. Line
330 Ft. from W. Line

SECTION PLAT

"Old well Deepen"

Location
Rig up JD 3x05
Drilling and Remarks:

Rigging up to
Deepen.

RECORD

Cased in., ft.
Sand
Gas
Oil
Total Depth

PRODUCTION

1st 24 hrs. Nat.
1st 24 hrs. after shot
Gas Cu. Ft.
Dry Hole
Abandoned

Date

MAY 27 1931

CHAS. L. SHERWOOD

Check location

We show Gypsy
#3 Hamant in SE-NW-SW of
14-26-2E - Depth 49feet.

SECTION PLAT


FIRST REPORTS

From N. line

From S. line

From E. line

From W. line

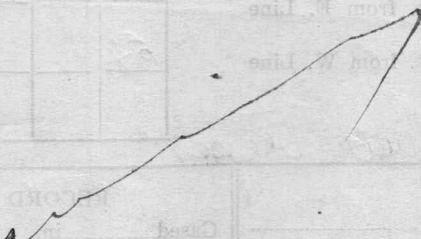

Returned	
Cards	
Tracing	
France Map	
Scarborough Map	
Moody Map	
Scarborough Plat Book	
Moody Plat Book	

KANSAS

Seagwick

E

Map No. Sec. 14 Twp. 26 R. 2

Well No. 3 Hainant

Gypsy Oil Co Company

Contractor

CORRECTION

SECTION PLAT

50			

990 Ft. from N. Line

..... Ft. from S. Line

..... Ft. from E. Line

330 Ft. from W. Line

Location

Rig up

Drilling and Remarks:

RECORD

Cased..... in., ... ft.

Sand

Gas

Oil

Total Depth

PRODUCTION

1st 24 hrs. Nat.

1st 24 hrs. after shot

Gas Cu. Ft.

Dry Hole

Abandoned

Date

JUN 3

1931

CHAS. L. SHERWOOD

192.....

Scout

Change
of
Location
above
well.

13 KANSAS

Map No. Sec. 14 Twp. 26 R. 2 E

Well No. 3 R. Hamant

Gypsy Oil Co Company

Contractor

COMPLETE

SECTION PLAT

0			

990 Ft. from N. Line

Ft. from S. Line

Ft. from E. Line

330 Ft. from W. Line

Location

Rig up

Drilling and Remarks:

115 Bbls.

RECORD

Cased in, ft.

Sand 3315-3327

Gas

Oil

Total Depth 3327

PRODUCTION

1st 24 hrs. Nat.

1st 24 hrs. after shot

Gas Cu. Ft.

Dry Hole

Abandoned

Date

JUL 8 1931

192

CHAS. L. SHERWOOD

Scout