


Section 29 Township 30 Range 7E

Well No. #6 Stalp

Company K. T. Weidemann

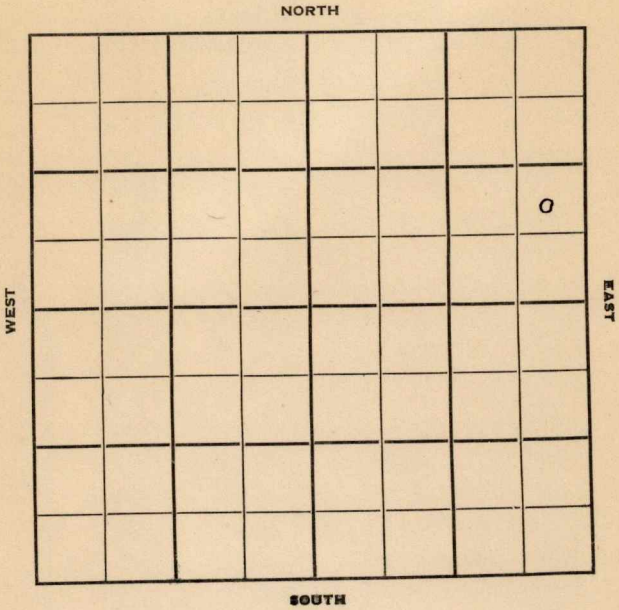

Cowley

KANSAS

Sec. 29 Twp. 30 R. 7E ✓

Well No. #6 Stalp Farm

K. T. Weidemann Company

Contractor

Box Pool


Ft. from N. Line

990' Ft. from S. Line

330' Ft. from E. Line

Ft. from W. Line

NE SE NE

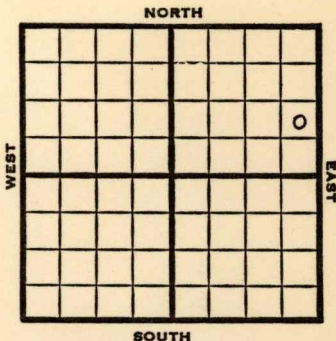

1951 Elev. 1441' REPORT

8/8 Spud 8-4-51
8" @ 40
Drlg. 580'

12/19 Spud 8-4-51
D & A TD 2891' 8" @ 40
Miss 2851-53' 4" @ 2853'
TD 2891' D & A

ABANDONED

County **Cowley** State **Kansas**

Sec. **29** (Blk. **30**) (Sur. **7E**) (Twp.) Map No.

Operator **K. T. Weidemann**

Well No. **6** Farm **Stalp**

Elev. **1441** Location **NE SE NE**

FIRST REPORT					

990 Ft. From **S** Line **NE**

330 Ft. From **E** Line Quarter

1st. Report **AUG 8 1951**

Completion

Remarks

Spudding Date **8-4-51**

Drlg. Data **Box Pool**

8" @ 40 drlg. 580

J. E. TYRA

County Cowley State Kansas

Sec. 29 (Blk. 30 (Sur. 7E (Twp. Map No.

Operator K. T. Weidemann

Well No. 6 Farm Stalp

Elev. 1441 Location NE SE NE

990 Ft. From S Line NE
330 Ft. From E Line Quarter

1st. Report

Completion DEC 1 9 1951

Remarks Box Pool

Spudding Date 8-4-51

Drig. Data D & A TD 2891

8" @ 40 Miss. 2851-53 4" @ 2853

TD 2891

D & A

J. E. TYRA