

Sedgwick

Form 252-A
5M 4-32 MPC

Map No. KANSAS Sec. 14 Twp 26 R. 2^E

Well No. 8-Hamant Farm



990 Ft. from N. Line

_____ Ft. from S. Line

_____ Ft. from E. Line

330 Ft. from W. Line

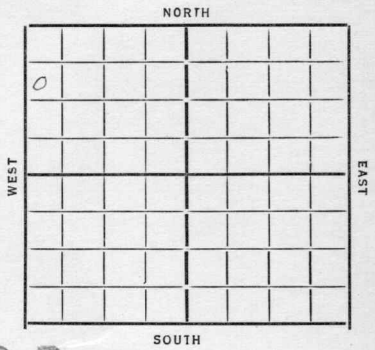

1932 AWDD

Date	REPORT
12/28	<i>ROS.</i>
1/33	
1/4	<i>Bldg rig</i>
1/11	<i>Rig up</i>
1/18	<i>15"-170</i>
	<i>Dreg 790'</i>
1/25	<i>HFW 1372-82</i>
	<i>set 133/8"-1401</i>
	<i>Clg out</i>
2/1	<i>10"-2010'</i>
	<i>Dreg 2325'</i>
2/8	<i>" " 2715'</i>
2/15	<i>8"-2838</i>
	<i>Chat 2847-50 TD</i>
	<i>2500 ft oil 2 hrs</i>
	<i>swab 65 bbl per hr</i>
2/22	<i>TD 2855'</i>
	<i>Jump 831 bbl oil and</i>
	<i>360 bbl water 24 hr</i>
	<i>Jump 163 bbl oil and</i>
	<i>150 bbl water 6 hr</i>
	<i>Will duped</i>

3/1- Chat 2852-55
T. D. 2855
pump 308 bbls
+ 844 bbls water
24 hours

(Comp)

O. W. D. D.

3/15- Chat 2852-55
T. D. 2855

O. W. D. D.

3/22 - 6" 2865 - 40 rly 2960

3/29 Bas line 3106 e.r. 6" 3135'

4/4 J.D. 3145 e.r. 6"

4/12 Viola 3155 $\frac{1}{2}$ - 3159' - J.D.

Pump 1187 bbls 24 hrs

Completed

Deerynick

E

13 KANSAS Map No. Sec. 14 Twp. 26 R. 7

Well No. 8 Hamant

Gypsy Oil Co Company

Contractor

FIRST REPORTS

990 Ft. from N. Line

Ft. from S. Line

Ft. from E. Line

330 Ft. from W. Line

SECTION PLAT

0			

Location

Rig up

Drilling and Remarks:

Pro G.

RECORD

Cased in., ft.

Sand

Gas

Oil

Total Depth

PRODUCTION

1st 24 hrs. Nat.

1st 24 hrs. after shot

Gas Cu. Ft.

Dry Hole

Abandoned

Date

DEC 28 1932

192

CHAS. L. SHERWOOD

Scout

Sedgwick

13

KANSAS

Map No. _____ Sec. *14* Twp. *26* R. *2* ^E

Well No. *8 Hamant*

Gypsy Oil Co

Company

Contractor

COMPLETED

SECTION PLAT

990 Ft. from N. Line

_____ Ft. from S. Line

_____ Ft. from E. Line

330 Ft. from W. Line

0			

Location _____

Rig up _____

Drilling and Remarks:

*Pump 308 Be Oil
844 Be Water
24 hours*

RECORD

Cased *8* in., *2838* ft.

Sand *Shot 2852-55*

Gas _____

Oil _____

Total Depth *2855*

PRODUCTION

1st 24 hrs. Nat. _____

1st 24 hrs. after shot _____

Gas _____ Cu. Ft.

Dry Hole _____

Abandoned _____

Date

MAR 1 1933

192

CHAS. L. SHERWOOD

Scout

Dedgwick

Map No. 13 KANSAS Sec. 14 Twp. 26 R. 2 E

Well No. 8 Hamant

Gypsy Oil Co Company

Contractor

FIRST REPORTS

990 Ft. from N. Line

..... Ft. from S. Line

..... Ft. from E. Line

330 Ft. from W. Line

SECTION PLAT

Location.....

Rig up.....

Drilling and Remarks:

old
Rigging up
to deepen

RECORD

Cased CP in. 2838 ft.

Sand Char 2852-55

Gas.....

Oil.....

Total Depth 2855

PRODUCTION

1st 24 hrs. Nat.....

1st 24 hrs. after shot.....

Gas..... Cu. Ft.

Dry Hole.....

Abandoned.....

Date

MAR 15 1933

192.....

CHAS. L. SHERWOOD

Scout

Deeghwick

13

KANSAS

Map No. _____ Sec. *14* Twp. *26* R. *2* E

Well No. *8 Hamant*

Gypsy Oil Co

Company

Contractor

COMPLETED

SECTION PLAT

990 Ft. from N. Line

_____ Ft. from S. Line

_____ Ft. from E. Line

330 Ft. from W. Line

<i>0</i>			

Location _____

Rig up _____

Drilling and Remarks:

*Pump 1187 B
24 Lems.*

RECORD

Cased _____ in., _____ ft.
 Sand *hold 3155 1/2 - 59*
 Gas _____
 Oil _____
 Total Depth *3159*

PRODUCTION

1st 24 hrs. Nat. _____
 1st 24 hrs. after shot _____
 Gas _____ Cu. Ft.
 Dry Hole _____
 Abandoned _____

Date

APR 12 1933

192

CHAS. L. SHERWOOD

Scout