

Sedgwick


Form 51-5M-2-29-34703

Map No. KANSAS Sec. 14 Twp. 26 R. 2 ^E

Well No. L. J. Hamant Farm

Lypsy Oil Company

NORTH

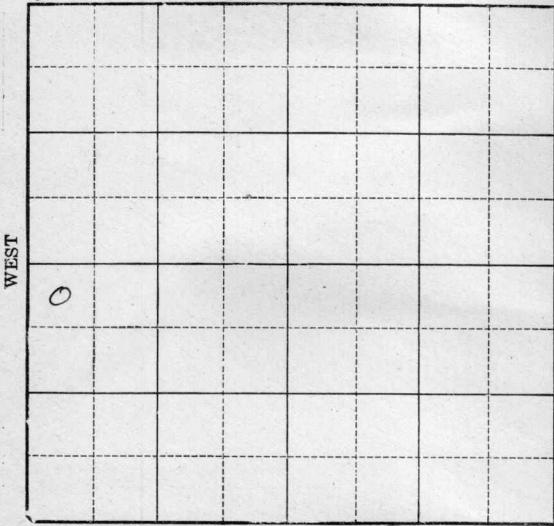

SOUTH

OWDD

Location _____

Drilling Remarks _____

Rig Up _____

Drilling Remarks _____

RECORD

Cased _____ in. _____ ft.

Sand _____

Gas _____

Oil _____

Total Depth _____

PRODUCTION

1st 24 hrs. Nat. _____

1st 24 hrs. after shot _____


Gas _____ cu. ft.

Dry Hole _____

Abandoned _____

Sedgwick
 Map No. **KANSAS** Sec. *14* Twp. *26* R. *2^E*
 Well No. *Q-2 Hamant* Farm
Gypsy Oil Company

330 Ft. from N. Line
 _____ Ft. from S. Line
 _____ Ft. from E. Line
330 Ft. from W. Line

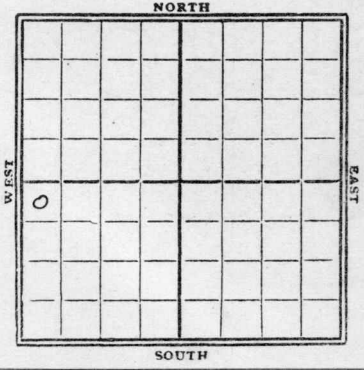

1929

Date	REPORT
<i>4/24</i>	<i>Location</i>
<i>5/1</i>	<i>Rig</i>
<i>5/8</i>	<i>only 400'</i>
<i>5/15</i>	<i>" 2090</i>
<i>5/22</i>	<i>" 2600'</i>
<i>5/29</i>	<i>" 3040</i>
<i>6/5</i>	<i>" 3135</i>
<i>6/12</i>	<i>Simpson 3334-37</i> <i>T.D. 3337</i> <i>swab 1305 bbls</i> <i>Pump.</i>
<i>1932</i>	<i>OWDID</i>
<i>9/14</i>	<i>Old TD 3337</i> <i>Begin up to deepen</i>
<i>9/21</i>	<i>Drill 3265</i>
<i>9/30</i>	<i>by Welcox 3281</i> <i>TD 3286' 4 1/2" 6"</i>
<i>10/5</i>	<i>TD 3336 fishing</i>
<i>10/12</i>	<i>Cem 6" 3337</i>
<i>10/19</i>	<i>—</i>

(over)

10/26 - TD 3376' HFW

P.B. to 3370

buil 1 bair oil per hr
No water

Well pump

11/2 -

Cased 6" - 3337

Top Simpson 3334

HFW 3376

TD 3376

P.B. 3370

shot 15 qt 3359-64

Made 96 bbl

Comp.

Map No. KANSAS Sec. 14 Twp. 26 R. 21

Well No. 2 Hamant

Gypsum Oil Company

Contractor

SECTION PLAT

330 Ft. from N. Line

..... Ft. from S. Line

..... Ft. from E. Line

330 Ft. from W. Line

0			

FIRST REPORTS

Location.....

Rig up.....

Drilling and Remarks:

RECORD

Cased..... in., ft.

Sand.....

Gas.....

Oil.....

Total Depth.....

PRODUCTION

1st 24 hrs. Nat.....

1st 24 hrs. after shot.....

Gas..... Cu. Ft.

Dry Hole.....

Abandoned.....

Date

APR 24 1929

S. J. LEWIS

192.....

Scout

Map No. **KANSAS** Sec. 14 Twp. 26 R. 2E

Well No. 2 Harmon

Gypsy Oil Company

Contractor

SECTION PLAT

330 Ft. from N. Line

..... Ft. from S. Line

..... Ft. from E. Line

330 Ft. from W. Line

0			

COMPLETED

Location.....

Rig up.....

Drilling and Remarks:

Simpson 3334
& 3337

Swatt 13057 ft

RECORD

Cased..... in., ft.

Sand.....

Gas.....

Oil.....

Total Depth..... 3337

PRODUCTION

1st 24 hrs. Nat.....

1st 24 hrs. after shot.....

Gas..... Cu. Ft.

Dry Hole.....

Abandoned.....

Date

JUN 12 1929

192

S. J. LEWIS

Scout

Seag Vista

E

13 KANSAS
Map No. Sec. 14 Twp. 26 R. 2

Well No. 2 Hamant

Gypsy Oil Co Company

..... Contractor

FIRST REPORTS

330 Ft. from N. Line

..... Ft. from S. Line

..... Ft. from E. Line

330 Ft. from W. Line

SECTION PLAT

	11		
	O.W.D.		
o			

Location

Rig up

Drilling and Remarks:

*Rigging up
to deepen*

RECORD

Cased *11* in., ft.

Sand *top Simpson 3334*

Gas

Oil

Total Depth *3337*

PRODUCTION

1st 24 hrs. Nat.

1st 24 hrs. after shot

Gas Cu. Ft.

Dry Hole

Abandoned

Date

SEP 14 1932

CHAS. L. SHERWOOD
192 Scout

Seely Wick

13 KANSAS
Map No. _____ Sec. 14 Twp. 26 R. 2 ^E

Well No. 2 Hamant

Gypsy Oil Co Company

Contractor

COMPLETED

SECTION PLAT

330 Ft. from N. Line

_____ Ft. from S. Line

_____ Ft. from E. Line

330 Ft. from W. Line

o			

Location _____

Rig up _____

Drilling and Remarks:

HFV at 3376

*Plug Back to 3370
Shot 15/3359-64
96 Bls.*

RECORD

Cased 6 in., 3337 ft.

Sand *Dempson* 3334

Gas _____

Oil _____

Total Depth 3376

PRODUCTION

1st 24 hrs. Nat. _____

1st 24 hrs. after shot _____

Gas _____ Cu. Ft.

Dry Hole _____

Abandoned _____

Date

NOV 2 1932

CHAS. L. SHERWOOD

192 Scout