

NORTH

WEST

EAST

SOUTH

Drilling Remarks

Drilling Remarks

RECORD

Total Depth_____

PRODUCTION

Abandoned _____


Map No. KANSAS Sec. 14 Twp. 26 R. 2^E
 Well No. 4 - Hamant Farm
Gypsy Oil Company

330 Ft. from N. Line

_____ Ft. from S. Line

_____ Ft. from E. Line

330 Ft. from W. Line

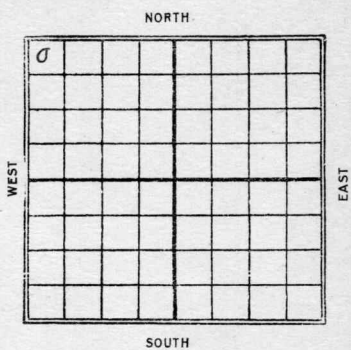

1929

Date	REPORT
10/30	Bldy Rig (rotary)
11/6	60' sur pipe
11/13	llg 1780
11/20	Rst 2850
11/27	Chat 2856-80 swabbed 500 bbls water and 40 bbls oil - will go to surface
12/4	llg 2880
12/11	" 2942 6" - 2939
12/18	show oil & gas 3154 sdy line 3154-56 1/2' 1000' fluid in 2 hrs.
12/23	show water sand 3154-56 1/2' T.D. 3156 1/2' swab 440 bbl oil Somp

Deelgwick
 Map No. **KANSAS** Sec. *14* Twp. *26* R. *2E*

13
 Well No. *4 Haman*

Gary Oil Company

Gary Contractor

SECTION PLAT

330 Ft. from N. Line

..... Ft. from S. Line

..... Ft. from E. Line

330 Ft. from W. Line

FIRST REPORTS

<i>0</i>			

Location.....

Rig up.....

Drilling and Remarks:

Rotary
Building rig

RECORD

Cased.....in., ...ft.

Sand.....

Gas.....

Oil.....

Total Depth.....

PRODUCTION

1st 24 hrs. Nat.....

1st 24 hrs. after shot.....

Gas.....Cu. Ft.

Dry Hole.....

Abandoned.....

Date

OCT 30 1929

192

S. J. LEWIS

Scout

Bedgwick
 Map No. KANSAS Sec. 14 Twp. 26 R. 2E

Well No. 4 Haman

Gypsy Oil Company

Contractor

SECTION PLAT

0			

330 Ft. from N. Line

..... Ft. from S. Line

..... Ft. from E. Line

330 Ft. from W. Line

COMPLETED

Location.....

Rig up.....

Drilling and Remarks:

Swat 844088 1/2

RECORD

Cased..... in., ... ft.

Sand 31.54 - 56 1/2

Gas.....

Oil.....

Total Depth 31.56 1/2

PRODUCTION

1st 24 hrs. Nat.....

1st 24 hrs. after shot.....

Gas..... Cu. Ft.

Dry Hole.....

Abandoned.....

Date

DEC 23 1929

192

S. J. LEWIS

Scout