


Map No. *Sedgwick* **KANSAS** Sec. *14* Twp. *26* R. *2E*

Well No. *6-Hamant* Farm

*Gypsy Oil Co* Company

NORTH

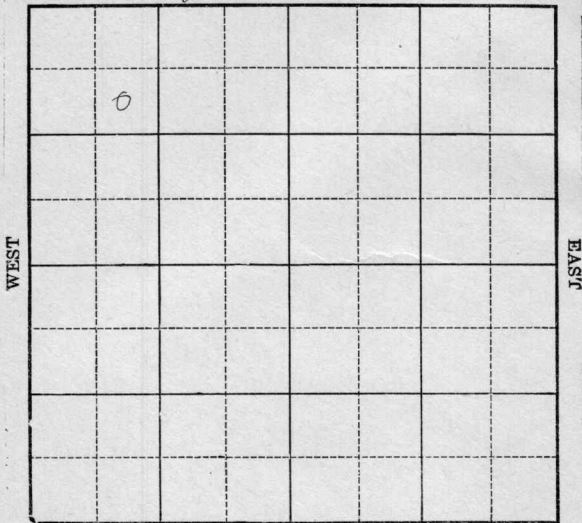

SOUTH

*O. W. D. D.*

Location \_\_\_\_\_

Drilling Remarks \_\_\_\_\_

Rig Up \_\_\_\_\_

Drilling Remarks \_\_\_\_\_

**RECORD**

Cased \_\_\_\_\_ in. \_\_\_\_\_ ft.

Sand \_\_\_\_\_

Gas \_\_\_\_\_

Oil \_\_\_\_\_

Total Depth \_\_\_\_\_

**PRODUCTION**

1st 24 hrs. Nat. \_\_\_\_\_

1st 24 hrs. after shot \_\_\_\_\_

Gas \_\_\_\_\_ cu. ft.


Dry Hole \_\_\_\_\_

Abandoned \_\_\_\_\_

Map No. KANSAS Sec. 14 Twp. 26 R. 2E

Well No. 6 - Hamant Farm  
Gypsy Oil Company

990 Ft. from N. Line  
\_\_\_\_ Ft. from S. Line  
\_\_\_\_ Ft. from E. Line  
990 Ft. from W. Line

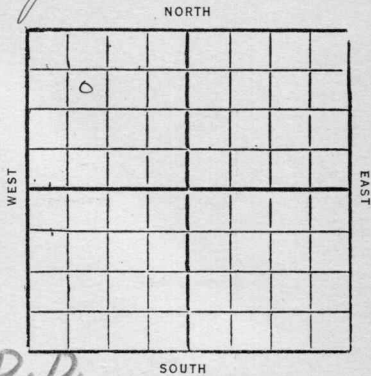

1932 O.W.D.D.

Date	REPORT
3/16	Loc
3/22	Clear
3/30	Mud
4/6	Spud
4/13	Drill 960
4/20	" 12" - 1375
	Drill 1640
4/27	" 2240'
5/4	" 2705
5/11	Mud 8 1/4" - 2844
5/18	Chat 2846-48
	SD 2848
5/25	Chat 2859-65
	TD 2865
	Cumpr 202 bbl oil and 65 " water in 20 hrs Compr
1933	O.W.D.D.
3/22	T. D. 2865' To DEEPEN
3/29	
4/4	6" 2890 dily 2970

1933

4/12 Br L 3105 J.D. 3145 U.R. 6"

4/19 Viola 3153-59 swab 402 bbb  
8 hrs

4/26 - 6" - 3142' Viola 3153-59  
J.D. 3159'

Run p. 1385 bbb 24 hrs

Completed

*Seeghwick*

13 KANSAS

E

Map No. \_\_\_\_\_ Sec. 14 Twp. 76 R. 7

Well No. 6 Hamant

Gypsy Oil Co Company

Contractor \_\_\_\_\_

FIRST REPORTS

SECTION PLAT

990 Ft. from N. Line

\_\_\_\_\_ Ft. from S. Line

\_\_\_\_\_ Ft. from E. Line

990 Ft. from W. Line

0			

Location ✓

Rig up \_\_\_\_\_

Drilling and Remarks:

RECORD

Cased \_\_\_\_\_ in., \_\_\_\_\_ ft.

Sand \_\_\_\_\_

Gas \_\_\_\_\_

Oil \_\_\_\_\_

Total Depth \_\_\_\_\_

PRODUCTION

1st 24 hrs. Nat. \_\_\_\_\_

1st 24 hrs. after shot \_\_\_\_\_

Gas \_\_\_\_\_ Cu. Ft.

Dry Hole \_\_\_\_\_

Abandoned \_\_\_\_\_

Date

MAR 16 1932

19

CHAS. L. SHERWOOD

Scout

*Seebyrics*

13 KANSAS

Map No. .... Sec. *14* Twp. *76* R. *7*

Well No. *6* *Hamant*

*Gypsy Oil Co* Company

..... Contractor

COMPLETED

SECTION PLAT

*990* Ft. from N. Line

..... Ft. from S. Line

..... Ft. from E. Line

*990* Ft. from W. Line


Location .....

Rig up .....

Drilling and Remarks:

*Pump 707 bbls  
oil & 65 bbls water  
in 20 hours.*

RECORD

Cased *7* in., *15* ft.

Sand *Chas 7859-65*

Gas .....

Oil .....

Total Depth *7865*

PRODUCTION

1st 24 hrs. Nat. ....

1st 24 hrs. after shot .....

Gas ..... Cu. Ft.

Dry Hole .....

Abandoned .....

Date

MAY 25 1932 CHAS. L. SHERWOOD

*Brad Nuck*

*13* KANSAS

Map No. .... Sec. *14* Twp. *26* R. *2* E

Well No. *6* *Hamant* .....

*Gypsy Oil Co* ..... Company  
..... Contractor

FIRST REPORTS

*990* Ft. from N. Line  
..... Ft. from S. Line  
..... Ft. from E. Line  
*990* Ft. from W. Line

SECTION PLAT

o			
"OKD"			
~			

Location .....

Rig up .....

Drilling and Remarks:

*Rigging up  
to Deepen*

RECORD

Cased *Chat 7859-65* in. .... ft.  
Sand .....  
Gas .....  
Oil .....  
Total Depth *7865* .....

PRODUCTION

1st 24 hrs. Nat. ....  
1st 24 hrs. after shot .....  
Gas ..... Cu. Ft.  
Dry Hole .....  
Abandoned .....

Date

MAR 22 1933

CHAS. L. SHERWOOD

192 ..... Scout

13 KANSAS

Map No. Sec. 14 Twp. 26 R. 7 E

Well No. 6 Hamant

Gypsy Oil Co Company

Contractor

COMPLETED

SECTION PLAT

0			

990 Ft. from N. Line

Ft. from S. Line

Ft. from E. Line

990 Ft. from W. Line

Location

Rig up

Drilling and Remarks:

Pump 1385  
Bls 24 Hamant

RECORD

Cased 6 in. 3147 ft.

Sand Viola 3153-59

Gas

Oil

Total Depth 3159

PRODUCTION

1st 24 hrs. Nat.

1st 24 hrs. after shot

Gas Cu. Ft.

Dry Hole

Abandoned

Date

APR 26 1933

192

CHAS. L. SHERWOOD

Scout