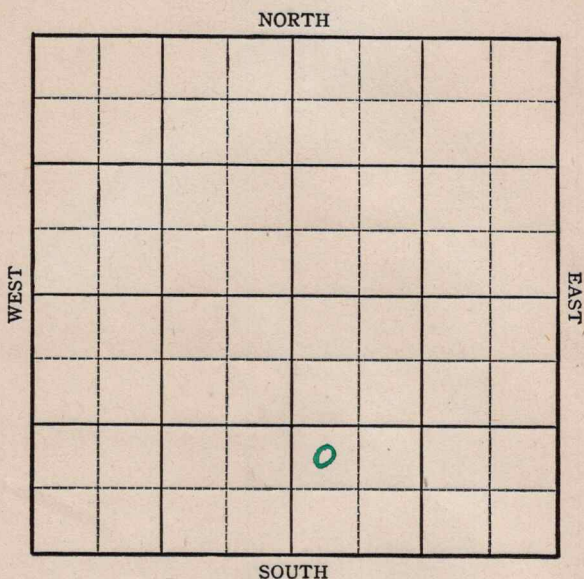


KANSAS

Barton

Section 28 Township 20 Range 12-WWell No. #1 BrownCompany Ferrier Drlg.

KANSAS

Barton County

Sec. 28 Twp. 20 R. 12W


Well No. #1 Brown Farm

Ferrier Drlg.

Company

Marchard West

NORTH

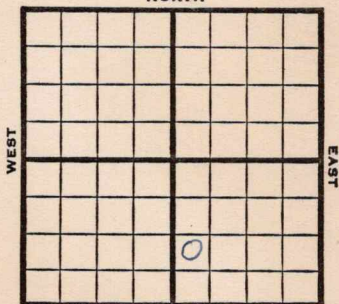

 Ft. from N. Line

990 Ft. from S. Line

 Ft. from E. Line

330 Ft. from W. Line

NW SW SE

SOUTH

1946

Elev. 1843

REPORT

2/20 Location

2/28 R.U.R.

3/7 10" - 280' Drlg. 1985'

3/14 Drlg. 2990'

3/20 Lans 3181

Arb. 3449


TD 3496'

ABANDONED

KANSASKansas Pool Name Marchard WestMap No. 46 Sec. 28 Twp. 20 R. 12WWell No. 1 BrownFerrier Drlg. CompanyFIRST REPORT Contractor

NW SW SE

SECTION PLAT

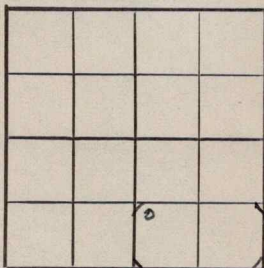 Ft. from N. Line990 Ft. from S. Line Ft. from E. Line330 Ft. from W. LineBarton CountyLocation XRig up Drilling and Remarks:

RECORD

Cased in., ft.Sand Gas Oil Total Depth

PRODUCTION

1st 24 hrs. Nat. 1st 24 hrs. after shot Gas Cu. Ft.Dry Hole Abandoned

Date

FEB 20 1946 19S. J. LEWIS Scout

KANSASKansas Pool Name Marquard WestMap No. 46 Sec. 28 Twp. 20 R. 12WWell No. 1 BrownFerrier Drlg.

Company

ABANDONED

Contractor

NW SW SE

E11843
SECTION PLAT Ft. from N. Line990 Ft. from S. Line Ft. from E. Line330 Ft. from W. Line

		0	

Barton County

Location Rig up

Drilling and Remarks:

Lions 357Per 43449

RECORD

Cased in., ft.Sand Gas Oil Total Depth 3496

PRODUCTION

1st 24 hrs. Nat. 1st 24 hrs. after shot Gas Cu. Ft.Dry Hole Abandoned

Date

MAR 20 1946

19

S. J. LEWIS

Scout