


Section 33 Township 18 Range 13 W

Well No. # 1 Byers

Company Murfin Drlg.

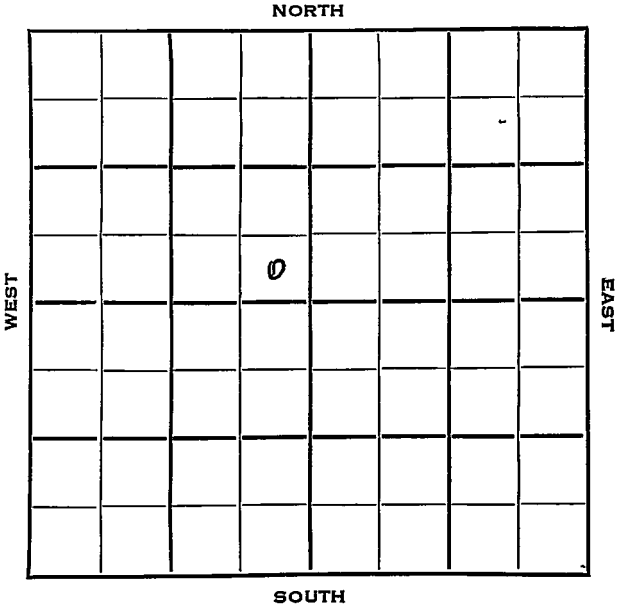

## Barton

KANSAS

|      |      |     |
|------|------|-----|
| SEC. | TWP. | R.  |
| 33   | 18   | 13W |

WELL NO.

1 Byers

FARM

COMPANY

Murfin Drlg.

CONTRACTOR

Wildcat

Ft. from N. Line


330

Ft. from S. Line

330

Ft. from E. Line

Ft. from W. Line

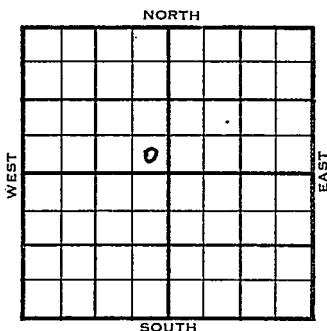

SE SE NW

Phillips - acreage

| 1953  | ELEVATION                           | REPORT |
|-------|-------------------------------------|--------|
|       | 1910'                               |        |
| 9/9   | Cellar & Pits                       |        |
| 9/16  | "                                   |        |
| 9/30  | 8" @ 201'                           |        |
|       | Anhy 815'                           |        |
|       | Drlg.                               |        |
| 10/7  | Top 2819' Heeb 3078' Tor 3080'      |        |
|       | Br li 3166 Lans 3180                |        |
|       | DST 3387-3421 35 mins, 3' M         |        |
|       | Arb. 3416                           |        |
|       | DST 3421-31, 1/4 hr, 32' OCM 1120#  |        |
|       | DST 3428-34, 1 hr, 220' gas, 432'   |        |
|       | oil, 940# FP 110# RTD 3434          |        |
|       | Schl 5" @ 3412'                     |        |
| 10/14 | WOCT                                |        |
| 10/21 | CO 3434' S/7 BOPH 7 hrs. 1800' O.B. |        |
| 10/28 | NR                                  |        |
| 11/4  | "                                   |        |
| 11/11 | "                                   |        |

VER

1953

11/18

Spind 9-29-53

Oil Well

TD 3434'

8" @ 201'

Anhy 815', Top 2819', Heeb 3078',

Tor 3080', Br lime 3166', Lams  
3180'

DST 3387-3421', opn 35 mins., rec. 3'  
mud

Arb. 3416'

DST 3421-31', opn  $\frac{1}{4}$  hrs., rec. 32'

ocm, 1120#

DST 3428-34, opn 1 hr., rec. 220' gas,  
432' oil, 940#

TD 3434'

5" @ 3412'

CO to 3434


S/7 boph

Comp. 452 bopd

COMPLETED

J. G. McGEHEE

County Barton State Kansas  
 Sec. 33 (Blk. 18 (Sur. 13W Map No.  
 Operator Murfin Drlg.  
 Well No. 1 Farm Byers  
 Elev. 1910 Location SE SE NW

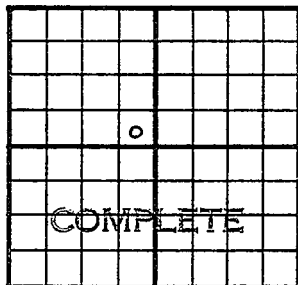

330 Ft. From S Line NW  
330 Ft. From E Line Quarter  
 Ist. Report  
 Completion NOV 18 1953  
 Remarks Wildcat  
 Spudding Date 9-29-53

Drlg. Data Oil well TD 3434  
8" @ 201 Anhy 815 Top. 2819  
Heeb. 3078 Tor. 3080 Br. lime 3166  
Lans. 3180 DST 3387-3421 open 35 min.  
Rec. 3' mud Arb. 3416 DST 3421-31  
open  $\frac{1}{2}$  hr. Rec. 32' ocm 1120#  
DST 3428-34 open 1 hr. Rec. 220' gas  
432' oil 940# TD 3434 5" @ 3412  
CO to 3434 S/ 7 boph Comp. 452 bopd

J. G. McGEHEE