


Map No. Range 33 Sec. 33 Twp. 30 R. 7

Well No. 1 Simmons Farm _____
Hershey et al. Company _____

NORTH

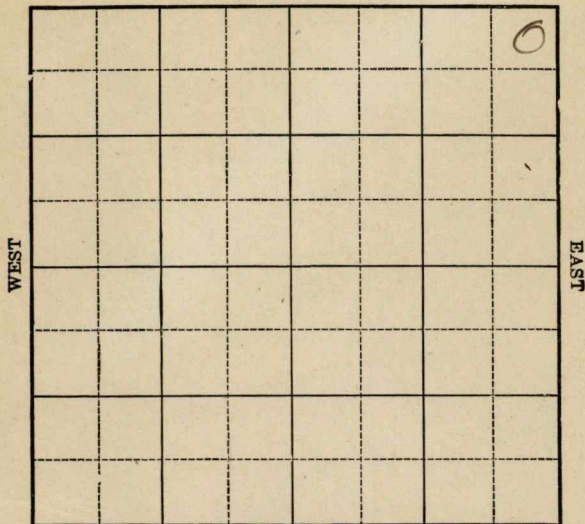

SOUTH

Location _____
Drilling Remarks _____

Rig Up _____
Drilling Remarks _____

RECORD

PRODUCTION

Cased _____ in. _____ ft.

Sand _____

Gas _____

Oil _____

Total Depth _____

1st 24 hrs. Nat. _____

1st. 24 hrs. after shot _____

Gas _____ cu. ft.

Dry Hole _____

Abandoned _____

Map No. Kan Sec. 33 Twp. 30 R. 7


Well No. 1 Simons Farm
Hershey et al Company

300 Ft. from N. Line

..... Ft. from S. Line

300 Ft. from E. Line

..... Ft. from W. Line

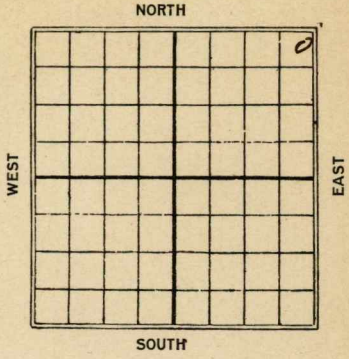

Date	REPORT
	1925
7/21	Bldg rig
8/7	
8/14	600
8/20	300
8/27	1150 UR
9/3	UR 10" to 1400'
9/11	N.F.W 1460-70' U.R. 10" 1480
9/16	same.
9/24	U.R. 8" J.W. 1900'
10/7	Oswego Line 1995-2175 slow oil
	2025 July 2175
10/8	July 2790
10/16	Stop Line 2765-10 July 2950
10/29	Abandoned 3135

Map No. 10 5426 Sec. 33 Twp. 30 R. 7

Well No. 1 SIMONS

Hershey & al Company

Contractor

FIRST REPORTS

SECTION PLAT

300 Ft. from N. Line
Ft. from S. Line
300 Ft. from E. Line
Ft. from W. Line

			0

Location _____
Rig up Blog
Drilling and Remarks:

RECORD

Cased _____ in., _____ ft.
Sand _____
Gas _____
Oil _____
Total Depth _____

PRODUCTION

1st 24 hrs. Nat. _____
1st 24 hrs. after shot _____
Gas _____ Cu. Ft.
Dry Hole _____
Abandoned _____

Date JUL 31 1925

CHAS. L. SHERWOOD
Scout

Cowley Co

Map No. K10 KANSAS Sec. 33 Twp. 30 R. 7

Well No. 1 Simons

Hershey et al Company

Contractor

COMPLETED

SECTION PLAT

300 Ft. from N. Line

_____ Ft. from S. Line

300 Ft. from E. Line

_____ Ft. from W. Line

			o

ABANDONED

Location _____

Rig up _____

Drilling and Remarks:

Aug 90, 1995 2175
Top hole 2765'
Wilcox 2125-32'
Dry & abd
L. J. 2135'

RECORD

Cased _____ in., _____ ft.

Sand _____

Gas _____

Oil _____

Total Depth 3135

PRODUCTION

1st 24 hrs. Nat. _____

1st 24 hrs. after shot _____

Gas _____ Cu. Ft.

Dry Hole

Abandoned

Date

OCT 29 1925

CHAS. L. SHERWOOD

192

Scout