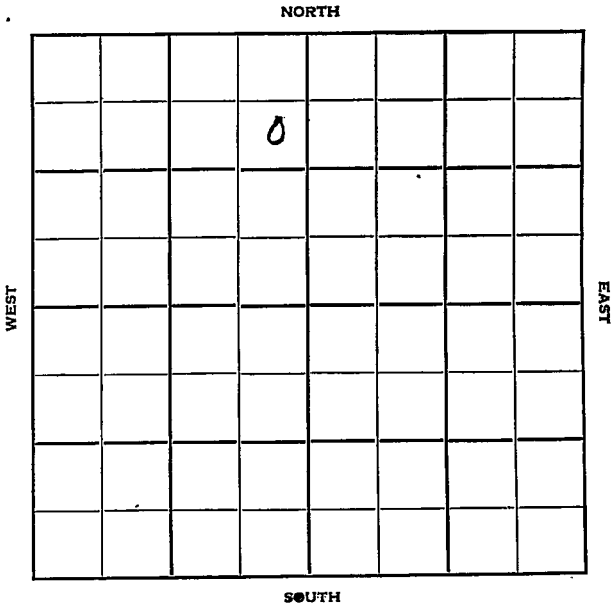


Section 33 Township 18 Range 13WWell No. #1 ByersCompany Alpine Oil

Barton

Sec. 33 Twp. 18 R. 13W

Well No. #1-Byers Farm

Alpine Oil

Company

Wildcat

Contractor

990

Ft. from N. Line


Ft. from S. Line

330

Ft. from E. Line

Ft. from W. Line

SE NE NW

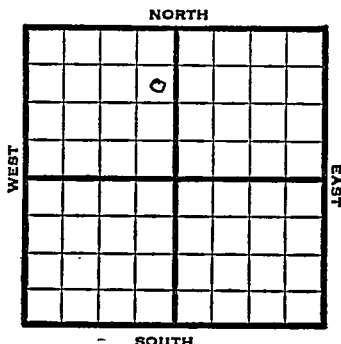

Phillips DHM

1952

Elev. 1888' REPORT

1/2

Spud 12-20-51

8" @ 255'

Heeb. 3057 Lans. 3160

DST 3154-3236 open 1 hr.

Rec. 40' mud & SSO

DST 3286-3320

1/9

Spud 12-20-51

D&A TD 3417

8" @ 255'

Heeb. 3057 Lans. 3160

DST 3154-3236 open 1 hr.

Rec. 40' mud & SSO

DST 3285-3320 open 1/2 hr.


Rec. 5' mud Cong. 3394

Arb. 3398 TD 3417

D&A

ABANDONED

County Barton State Kansas
 Sec. 33 (Blk. Twp.) 18 (Sur. Rge.) 13W Map No.
 Operator Alpine Oil
 Well No. 1 Farm Byers
 Elev. _____ Location SE NE NW

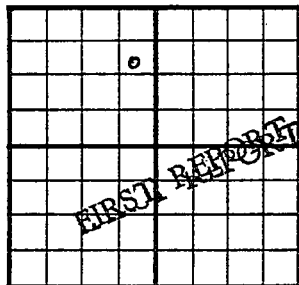


990 Ft. From N Line NW
330 Ft. From E Line Quarter
 Ist. Report JAN 2 1952
 Completion _____
 Remarks Phillips - DHM
 Spudding Date 12-20-51

Drlg. Data Wildcat
8" @ 255 Heeb. 3057 Lens. 3160
DST 3154-3236 open 1 hr. Rec. 40" mud
& SSO DST 3286-3320

J. E. TYRA

County Barton State Kansas
 Sec. 33 (Blk.) 18 (Sur.) 13W Map No.
 Operator Alpine Oil & Royalty
 Well No. 1 Farm Byers
 Elev. 1888 Location SE NE NW

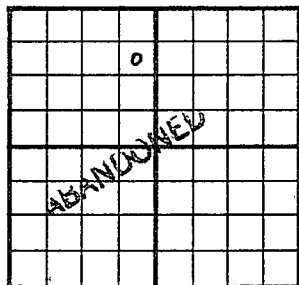

990Ft. From N Line NW
330Ft. From E Line Quarter
 Ist. Report
 Completion JAN 9 1952
 Remarks Wildcat
 Spudding Date 12-20-51

Drilg. Data D & A TD 3417
8" @ 255 Heeb. 3057 Lans. 3160
DST 3154-3236 open 1 hr. Rec. 40' mud
& SSO DST 3286-3320 open $\frac{1}{2}$ hr.
Rec. 5' mud Cong. 3394 Arb. 3398
TD 3417 D & A

J. E. TYRA