


Section 33 Township 30 Range 7E
 Well No. #1 Smith
 Company Leben Drlg.

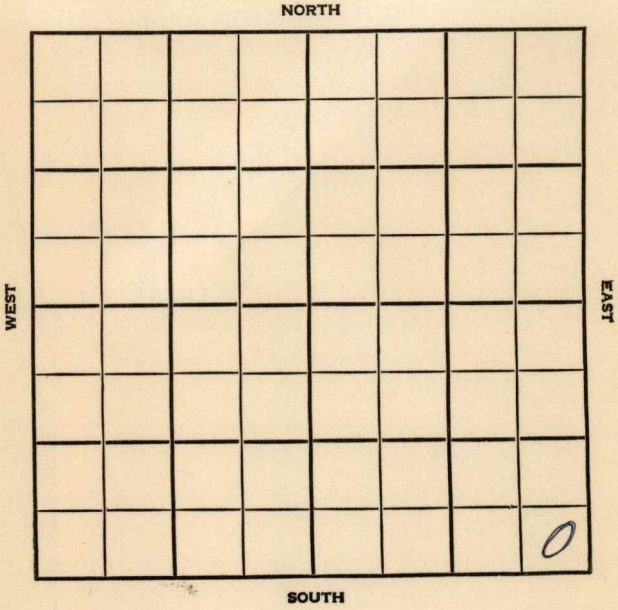

WILDCAT

FORM 513 SUNRAY

County Cowley Elev. _____
Sec. 33 Twp. 30 Rge. 7E
Company Leben Drlg.
Farm Name Smith No. 1

TOPS	DEPTH	LOG	DATUM	Loc. in Sec.
Anh.				SE SE SE
Tp.				
H.				
Tr.				
Dg.				
B.L.				
L.				Geol. _____
K.C.				Contr. _____
B.K.C.				Crisswell Tools
Ce.				Pool
C.				Wildcat
M.				
M.				
K.				
Mz.				
Mq.				
V.				
S.				
S.				
A.				
R.				
Pf.				
G.				
T.D.				

NOV 14 '55

FIRST REPORT

Date Comm. Sun (DHM)
Location _____

NOV 5 0 1955

R.G.

County <u>Cowley</u>				Elev. <u>1349</u>	Co.
Sec. <u>33</u>	Twp. <u>30</u>	Rgs. <u>7E</u>			
Company <u>Leben Drlg.</u>					
Farm Name <u>Smith</u> No. <u>1</u>					

TOPS	DEPTH	LOG	DATUM	Loc. in Sec.
Anb.				SE SE SE
Tr.				
H.				
Tr.				
Dg.				
Bl.				
L.	<u>1650</u>			Geol.
K.C.	<u>2042</u>			Contr.
B.K.C. <u>clev</u>	<u>2324</u>			Crisswell Tools
Ce.				
C.				
M.	<u>2791</u>			Pool
M.				Wildcat
K.				
Mz.				
Mo.				
V.	<u>2005</u>			
S. <u>lay</u>	<u>2016</u>			
S.				
A.				
R.				
PE.				
G.				
TR.	<u>2891</u>			

ABANDONED			
DEC	5	'56	
			0

Date Comm.

Sun (DHM)

Location NOV 21 '56

MERT 11-15-56

NOV 28 '56

878 68/75 DIT 2010

-39 1/2 sec 11' Md BHP 0/20"

DIT 2792-2800 on 1/2 20' Md

FP 10-10 BHP 160/20 DEC 5 '56

D & A