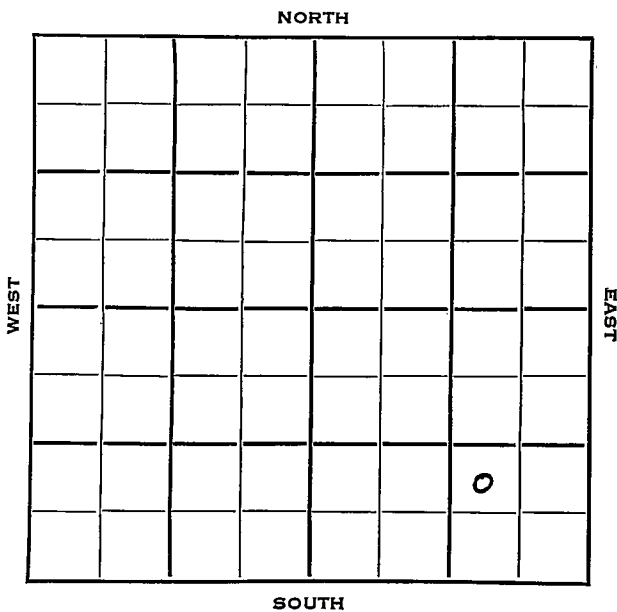


Section 33 Township 18 Range 13WWell No. 2 CurrayCompany Murfin Drlg.

Barton KANSAS

SEC.	TWP.	R.
33	18	13 W

WELL NO. # 2 Curray FARM

COMPANY


CONTRACTOR Murfin Drlg.

_____ Ft. from N. Line

990 _____ Ft. from S. Line

990 _____ Ft. from E. Line


_____ Ft. from W. Line

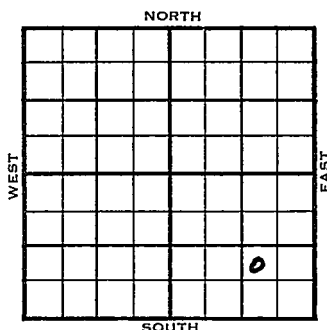

NW SE SE

	ELEVATION	REPORT
1953	1874'	
10/21	Spud 10-18-53 8" @ 209 Drlg. 730'	
10/28	Anhy 778', Heeb 3047', Br li 3136', KC 3149 DST 3152-80, 1/4 hrs., 7' M DST 3289-3320'	
11/4	D&A	
11/11	"	
11/18	Spud 10-18-53 D&A TD 3470' 8" @ 209' Anhy 778', Heeb 3047', Br lime 3136', KC 3149' DST 3152-80', opn $\frac{1}{4}$ hr., rec. 7' mud, O# DST 3289-3320', rec. 32' mud Arb. 3397' DST 3370-3403', opn 10 mins., rec. 10' mud DST 3403-07', failed DST 3401-07', opn $\frac{1}{4}$ hrs., rec. 15' mud 610# DST 3404-30, rec. 12' mud, TD 3470' D&A	

County Barton State Kansas
 Sec. 33 (Blk.) 18 (Sur.) 13W Map No.
 Operator Murfin Drlg.
 Well No. 2 Farm Curray
 Elev. 1874 Location NW SE SE

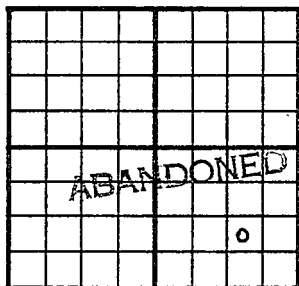

990 Ft. From S Line SE
990 Ft. From E Line Quarter

1st. Report

Completion NOV 18 1953

Remarks

Spudding Date 10-18-53

Drlg. Data D & A TD 3470

8" @ 209 Anhy 778 Heeb. 3047

Br. lime 3136 KC 3149 DST 3152-80

open $\frac{1}{4}$ hr. Rec. 7' mud 0# DST 3289-

3320 Rec. 32' mud Arb. 3397 DST 3370-

3403 open 10 min. Rec. 10' mud

DST 3403-07 failed DST 3401-07

open $\frac{1}{4}$ hr. Rec. 15' mud 610#

DST 3404-30 Rec. 12' mud TD 3470

D & A

J. G. McGEHEE