

O.W.D.D.

FORM 51 25M 3-49 PETROL

KANSAS

Barton

Section 28 Township 20 Range 12W

Well No. 1 Special #1 Special - SWD

Company G. Davis et al Alpine Oil & Royalty

Bryant

NORTH

NE NE NE

							0

WEST

EAST

SOUTH


Sec. 28 Twp. 20 R. 12W

Well No. 1 Special Farm _____

G. Davis et al Company _____

Bryant Pool

Barton
NORTH

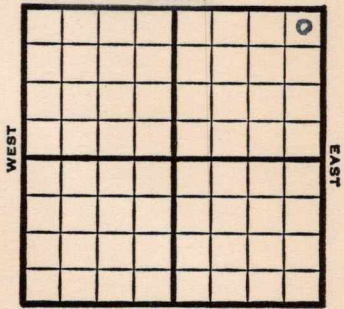

330 Ft. from N. Line

_____ Ft. from S. Line

330 Ft. from E. Line

_____ Ft. from W. Line

NE/C

1949 **Elev. 1840' REPORT**

9/28 8" @ 260'
Anhy 620'
Drlg. 2620'

10/5 **Lans 3171'**
Arb. 3482'
TD 3490'
Abd. **ABANDONED**

Map No. _____ Sec. 28 Twp. 20 R. 12W

Well No. 1 Special

G. Davis etal. Company

Contractor

NE/C

FIRST REPORT
SECTION PLAT

330 Ft. from N. Line

_____ Ft. from S. Line

330 Ft. from E. Line

_____ Ft. from W. Line

			0

Barton County

Location _____

Rig up _____

Drilling and Remarks:

8" @ 260

Anhy 620

drlg. 2620

RECORD

Cased _____ in., _____ ft.

Sand _____

Gas _____

Oil _____

Total Depth _____

PRODUCTION

1st 24 hrs. Nat. _____

1st 24 hrs. after shot _____

Gas _____ Cu. Ft.

Dry Hole _____

Abandoned _____

Date

SEP 28 1949 19

S. J. LEWIS

Scout

Kansas

Map No. _____ Sec. 28 Twp. 20 R. 12W

Well No. 1 Special

G. Davis et al. Company

ABANDONED

Contractor

NE/C

E. 1848
SECTION PLAT

			0

330 Ft. from N. Line

_____ Ft. from S. Line

330 Ft. from E. Line

_____ Ft. from W. Line

Barton County

Location _____

Rig up _____

Drilling and Remarks:

Home 8171
Cor 73482

RECORD

Cased _____ in., _____ ft.

Sand _____

Gas _____

Oil _____

Total Depth 3490

PRODUCTION

1st 24 hrs. Nat. _____

1st 24 hrs. after shot _____

Gas _____ Cu. Ft.

Dry Hole _____

Abandoned _____

Date

OCT 5 1949 19

S. J. LEWIS Scout

O. W. D. D

S-513-B

County Barton Elev. 1840 DF
 Sec. 28 Twp. 20 Rge. 12W
 Company Alpine Oil & Royalty
 Farm Name Spacil No. 1

TOPS	DEPTH	LOG	DATUM
Anh.			
Tp.			
H.			
Tr.			
Dg.			
B.L.			
L.			
K.C.			
B.K.C.			
Ce.			
C.			
M.			
M.			
K.			
Mz.			
Mq.			
V.			
S.			
S.			
A.			
R.			
Pf.			
G.			
T.D.			

Loc. in Sec. _____

NE NE NE

(OWDD for SWD)

Geol. O. W. D. D

Contr. _____

Pool _____

Workman NW

0
FIRST REPORT
 FEB 26 '58

Date Comm. _____

OLD INFO: Tops. OTD 3490, D & A (was G. Davis).
NEW INFO: DD G.W. 3974, 5" @ 3560 TD 3994.

Co.

Lse.

No.

Sec.

T.

R.

O. W. D. D

Twp. ~~Pool~~ ~~Facet~~

S-513-B

County Barton Elev. 1840 DF
Sec. 28 Twp. 20 Rge. 12W
Company Alpine Oil & Royalty
Farm Name Spacil No. 1

TOPS	DEPTH	LOG	DATUM
Anh.			
Tp.			
H.			
Tr.			
Dg.			
B.L.			
L.			
K.C.			
B.K.C.			
Ce.			
C.			
M.			
M.			
K.			
Mz.			
Ma.			
V.			
S.			
S.			
A.			
R.			
Pf.			
G.			
T.D.			

Loc. in Sec. NE NE NE
(OWDD for
SWD)

Geol. O. W. D. D
Contr.

Pool Workman NW

APR 23 '58
ABANDONE

Date Comm.

OLD INFO: Tops. OTD 3490, D & A (was G. Davis).
NEW INFO: DD G.W. 3974, 5" @ 3560 TD 3994. MAR 5 '58 woot

MAR 19 '58 MAR 26 '58 APR 2 '58 APR 9 '58 APR 16 '58

CO 3994 TD APR 23 '58 FU 2900' W
12 hrs (3) 2" TBG 3648

SWPW in ALB