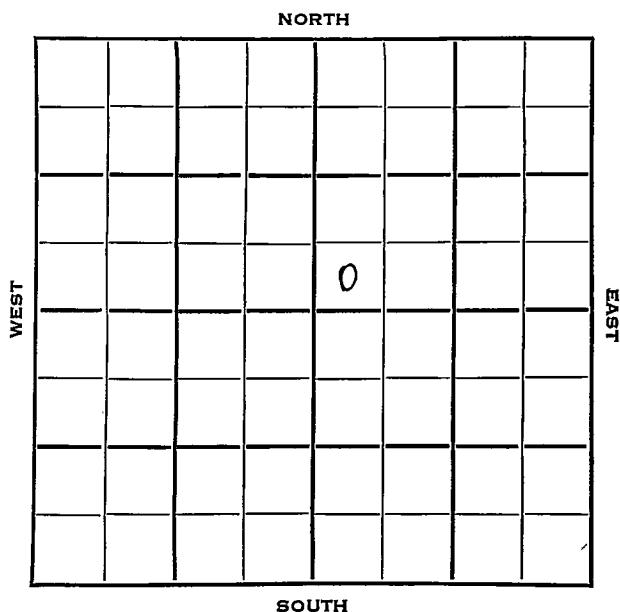


Section 33 Township 18 Range 13 WWell No. # 1 Curry "A"Company Phillips Pet.

Barton KANSAS

SEC.	TWP.	R.
33	18	13W ✓

WELL NO.

1 Curry "A"

FARM

COMPANY

Phillips Petr.

CONTRACTOR

Phillips


NW Hawkins Pool

_____ Ft. from N. Line

330 _____ Ft. from S. Line

_____ Ft. from E. Line

330 _____ Ft. from W. Line

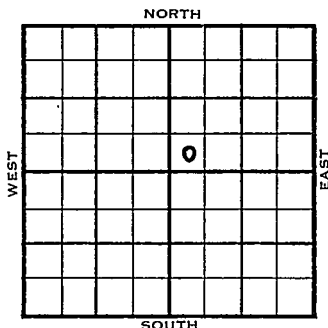

SW SW NE

	ELEVATION	REPORT
1953	1889'	

12/22

Spud 12-18-53

10" @ 472'

Drlg. 799'

1954

1/6

Spud 12-18-53

D & A

TD 3450'

10" @ 472'

Heeb 3061', Tor 3071', Doug 3086,

Br. Lime 3151', Lans 3162,

DST 3296'-3326' opn 1 hr, rec 3' Mud


O# B KC 3389' Arb 3409'

TD 3450'

D & A

ABANDONED


County **Barton** State **Kansas**
 Sec. **33** (Blk. Twp.) **18** (Sur. Rge.) **13W** Map No.
 Operator **Phillips. Pet.**
 Well No. **1** Farm **Curry "A"**
 Elev. Location **SW SW NE**

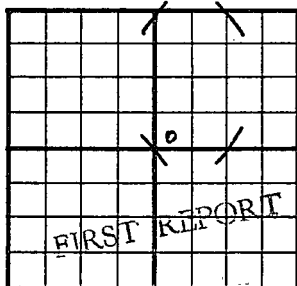

330 Ft. From **S** Line **NE**
330 Ft. From **W** Line **Quarter**
 1st. Report **DEC 4 2 1953**
 Completion'
 Remarks
Phillips - Contr.
 Spudding Date **12-18-53**

Drlg. Data **NW Hawkins Pool**
10" @ 472 drlg. 799

J. G. McGEHEE

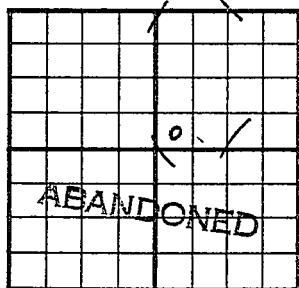County Barton State KansasSec. 33 (Blk. Twp.) 18 (Sur. Rge.) 13W Map No.Operator Phillips Pet.Well No. 1 Farm Curry "A"Elev. 1889 Location SW SW NE330 Ft. From S Line NE330 Ft. From W Line Quarter

1st. Report

Completion JAN 6 1954Remarks NW Hawkins PoolPhillips - Contr.Spudding Date 12-18-53Drlg. Data D & A TD 345010" @ 472 Heeb. 3061 Tor. 3071Doug. 3086 Br. lime 3151 Lans. 3162DST 3296-3326 open 1 hr. Rec. 3' mudO# B KC 3389 Arb. 3409 TD 3450D & A

J. G. McGEHEE