


Cowley

SECTION 4 TOWNSHIP 30 S RANGE 8 E

WELL NO. ~~# 5 Spence "A"~~ # 6 Zee "G"

COMPANY Beaumont Pst.

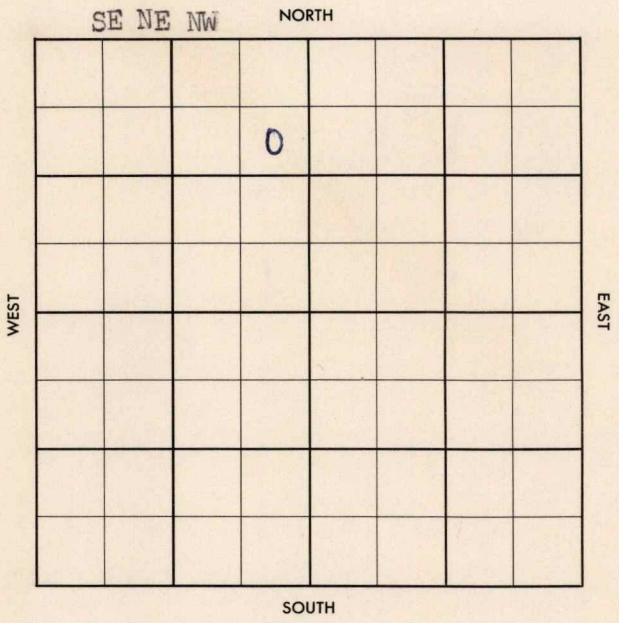

CORRECTION

36

FORM 513 SUNRAY

County COWLEY Elev. 1447 9rd
 Sec. 4 Twp. 30S Rge. 8E
 Company Beaumont Pet.
 Farm Name Spence^{2nd} FEE G No. 36

TOPS	DEPTH	LOG	DATUM	Loc. in Sec.
Anh.				SE NE NW
TP.				
H.				
Tr.				
Dg.				
BL.				
L.				
K.C.	1917			Geol.
B.K.C.				Contr.
Ce.				
C.				
M.				Pool
M.				Hannah
K.				
Mz.				
Mq.				
V.				
S.				
S.				
A				
R.				
PE.				
G.				
T.D.	2098			ABANDONED SEP 18 '57

Date Comm. MIRT AUG 28 '57 SPD 8-22
85/8 72/ 5 1/2 2097 SEP 4 '57
MICT SEP 11 '57 DD 2133 1500 acid
+ 5 x 9 all w TD 2133

D & A

Co.
Loc.
No.
Sec.
T.
R

County Cowley Elev. _____
 Sec. 4 Twp. 30S Rgs. 8E
 Company Beaumont Pet.
 Farm Name Spence "A" No. 5

TOPS	DEPTH	LOG	DATUM	Loc. in Sec.
Anh.				SE NE NW
Tr.				
H.				Geol.
Tr.				
Dg.				Contr.
Bl.				
L.				Pool
K.C.				
B.K.C.				Hannah
Ce.				
C.				FIRST REPORT AUG 21 '57
M.				
M.				T.D.
K.				
Mz.				
Me.				
V.				
S.				
S.				
A.				
R.				
Pe.				
G.				
T.D.				

Date Comm.

~~MIPT~~

~~30~~

Co.
Lse.
No.
Sec.
T.
R.