


Section 34 Township 18 Range 13W

Well No. 1 - Amerine

Company Rocket Drlg

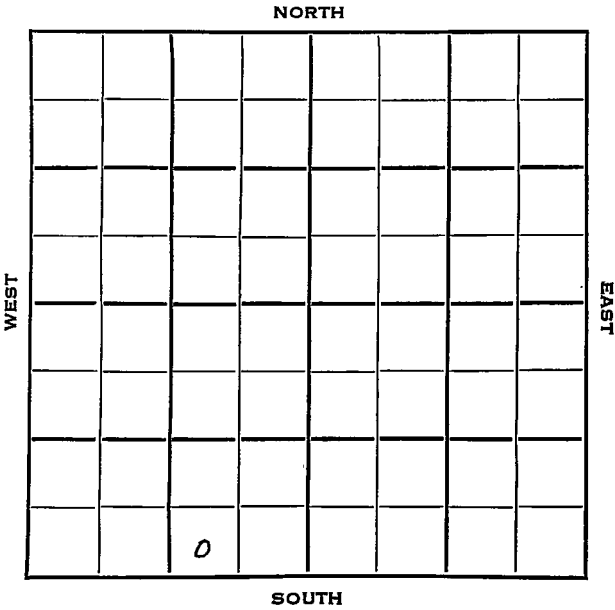

Barton

KANSAS ✓

Sec. 34 Twp. 18 R. 13WWell No. #1 Amerine FarmRocket Drlg. Company


Contractor

Ft. from N. Line

330 Ft. from S. Line990 Ft. from E. Line

Ft. from W. Line

SW SE SW

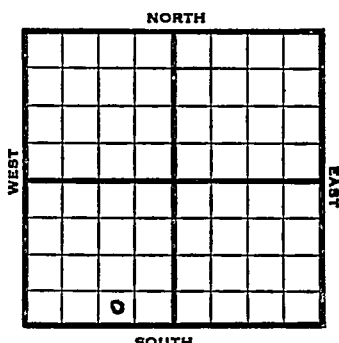

1952 Elev. 1875' REPORT

12/23 Location

12/25 " "

1/1 Drlg. 2800

1/8 Heeb 3042 Br 1 3131 Lans 3143 DST 3146-3226 2 Hrs. 480' Gas 40' O & GCM 120# DST 3261-3320 1 Hr. 1680' GO 180' O&GCM 450# Cong 3378 DST 3365-97 1 Hr. 3151 3151' M & Oil 780# Arb 3387 RTD 3397 5" @ 3388.

1/22 DD 3402 TD 1000A

S/1½ BOPH + 15% wtr.

PB 3370, 24/3302-10, 15/3293-98

SO 1000A

S/56 BO 4 hrs., POP

1/29 P/3 BOPH

2/5 NR

OVER

#1 Amerine

1953
2/11

Spud 12-24-52

Oil Well

TD 3402

8" @ 182

Anhy 764, Heeb 3042, Br lime

3131, Lans 3143

DST 3146-3226, opn 2 hrs.,

rec. 480' gas, 40' o & gcm, 120

DS¹ 3261-3320, opn 1 hr., rec.

1680' gas, 180' o & gcm, 450#

Cong 3378

DST 3365-97, opn 1 hr., rec.

315' mud & oil, 780#

Arb. 3387

TD 3397

5" @ 3388

DD 3402, 1000A

S/1 $\frac{1}{2}$ boph 15% wtr.

PB 3370


24/3302-10, 15/3293-98 SO

1000A S/56 bo 4 hrs.

P/3 boph

Comp. 33 bopd 25% wtr.

COMPLETED

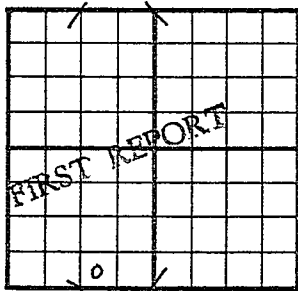County Barton State KansasSec. 34 (Blk.) 18 (Sur.) 13W Map No.Operator Rocket Drlg.Well No. 1 Farm AmerineElev. _____ Location SW SE SW330 Ft. From S Line SW990 Ft. From E Line Quarter1st. Report DEC 23 1952

Completion _____


Remarks _____

Spudding Date _____

Drlg. Data _____

Location

J. G. McGEHEE

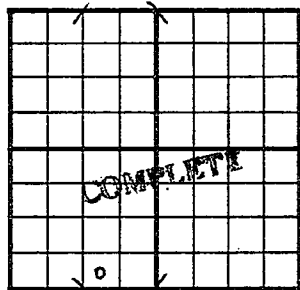County Barton State KansasSec. 34 (Blk. Twp.) 18 (Sur. Rge.) 13W Map No. _____Operator Rocket Drlg.Well No. 1 Farm AmerineElev. 1875 Location SW SE SW

330 Ft. From S Line SW

990 Ft. From E Line Quarter

1st. Report _____

Completion FEB 11 1953

Remarks _____

Spudding Date 12-24-52Drlg. Data Oil well TD 34028" @ 182 Anhy 764 Heeb. 3042Br. lime 3131 Lans. 3143 DST 3146-3226open 2 hr. Rec. 480' gas 40' o & gcm120# DST 3261-3320 open 1 hr. Rec.1680' gas 180' o & gcm 450# Cong. 3378DST 3365-97 open 1 hr. Rec. 315' mud &oil 3780# Arb. 3387 TD 3397 5" @ 3388DD 3402 1000 A S/ 1 1/2 bophr 15% wtr.PB 3370 24/ 3302-10 15/ 3293-98 SO

1000 A S/ 56 bo 4 hr. R/ 3 bophr

Comp. 33 bopd 25% wtr.