


Section 34 Township 18 Range 13 W

Well No. # 1 Taylor

Company Toklan Prod. Co.

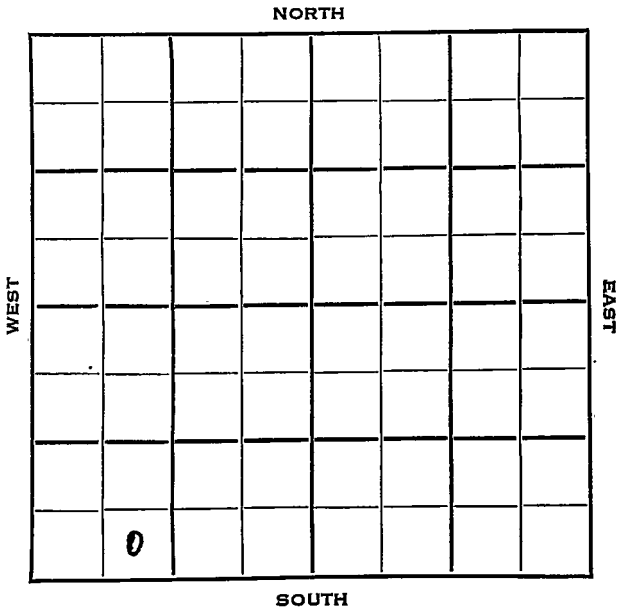


Barton

KANSAS ✓

Sec. 34 Twp. 18 R. 13WWell No. #1 Taylor FarmToklan Prod. Co. CompanyK & E Drlg. Contractor
Hawkins Pool Ft. from N. Line330 Ft. from S. Line Ft. from E. Line990 Ft. from W. Line

SE SW SW

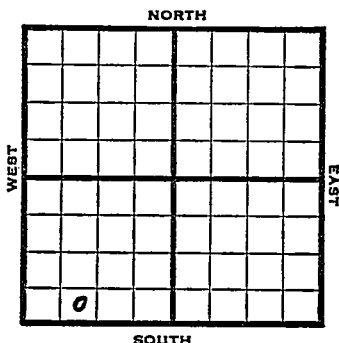

1953

Elev. 1897' REPORT

5/20.

Spud 5-18-53
8" @ 233; WOC

5/28

Drlg 3050

6/3

Heeb 3065, Br. L. 3152, Lans 3167,
DST 3171-3240 1 hr, 15' M
DST 3291-3338 1 hr, 230' ocm 400#
DST 3370-3426 1 hr, 33' ocm 230#
Arb 3422,
5" @ 3423'
TD 3426'

6/10

DD 3432 S.O. 500 A no help 750A
no help 1 bwph PB 3363

7/15

Spud 5-18-53 Oil well TD 3432
8" @ 233 Heeb 3065 Br lime 3152
Lans 3167
DST 3171-3240 open 1 hr rec 15' mud 0#
DST 3291-3338 open 1 hr rec 230' OCM
400#
DST 3370-3426 open 1 hr rec 33' OCM
230# Arb. 3422 5" @ 3423
TD 3426 DD 3432 500 A 750 A
1 BWPH PB 3363 24/3314-20
56/3326-40 1500 A S/5-3/4 BOPH
17/3172-76 26/3216-22 17/3226-30
2000 A S/3/4 BOPH P/84 BOPD
Comp. 24 BOPD 10% wtr.**COMPLETED**

8" @ 233 WOC

J. G. McGEHEE