


*Hudwick*  
Map No. KANSAS Sec. 15 Twp. 26 R. 2<sup>E</sup>  
Well No. 3-16 Brown Farm \_\_\_\_\_  
Shell Co Company \_\_\_\_\_

NORTH

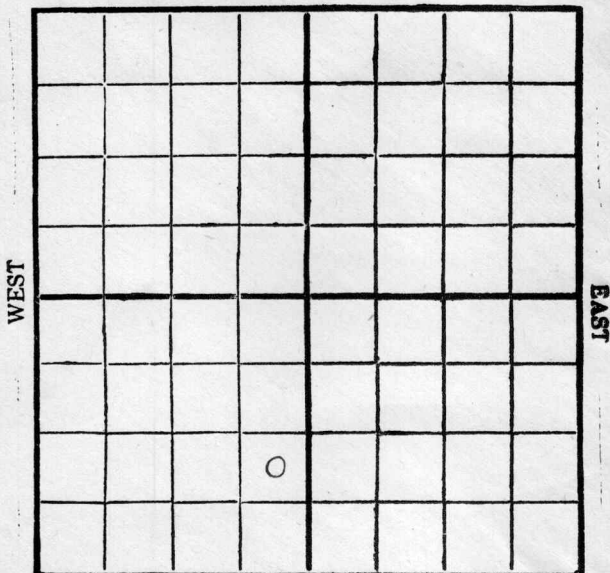

SOUTH

*OWDD*

Location \_\_\_\_\_

Drilling Remarks \_\_\_\_\_

Rig Up \_\_\_\_\_

Drilling Remarks \_\_\_\_\_

RECORD

Cased \_\_\_\_\_ in. \_\_\_\_\_ ft.

Sand \_\_\_\_\_

Gas \_\_\_\_\_

Oil \_\_\_\_\_

Total Depth \_\_\_\_\_

PRODUCTION

1st 24 hrs. Nat. \_\_\_\_\_

1st 24 hrs. after shot \_\_\_\_\_

Gas \_\_\_\_\_ cu. ft. \_\_\_\_\_

Dry Hole \_\_\_\_\_

Abandoned \_\_\_\_\_

Map No. KANSAS Sec. 15 Twp. 26 R. 2<sup>E</sup>

Well No. 3 - Brown Farm


Shell Pet Corp Company

..... Ft. from N. Line

1070 Ft. from S. Line

250 Ft. from E. Line

..... Ft. from W. Line

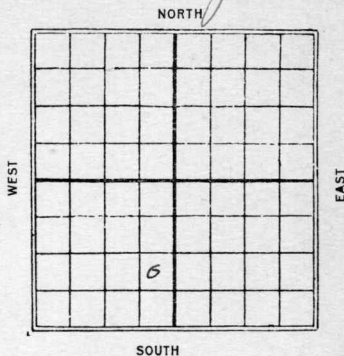

1929

Date

REPORT

Date	REPORT
10/19	Bldg Brg
10/16	Spud
10/23	Bldg 2279'
10/30	Cem 8" - 2865'
11/6	Shot 2889-93'
	T.D. 2893'
	swab 208 bbl oil
	" 6 " water
	Pump.
1932	ONDD
7/20	Old TD 2893
	6" - 3002'
7/27	Base line 3148
	TD 3183 U/R 6"
8/3	Cem 7" - 3193
8/10	Viola 3202-05
	Hole full oil
	ing tubing
8/17	Viola 3202-05
	TD 3205
	Pump 4-10 bbl 24 hr
	Pump.

*Sealgwick*

Map No. KANSAS Sec. 15 Twp. 26 R. 2E

Well No. 130 3 Brown

Shell Oil Co. Company

Contractor

SECTION PLAT

..... Ft. from N. Line

1070 Ft. from S. Line

250 Ft. from E. Line

..... Ft. from W. Line


FIRST REPORTS

Location.....

Rig up.....

Drilling and Remarks:

*Building rig*

RECORD

Cased..... in., ..... ft.

Sand.....

Gas.....

Oil.....

Total Depth.....

PRODUCTION

1st 24 hrs. Nat.....

1st 24 hrs. after shot.....

Gas..... Cu. Ft.

Dry Hole.....

Abandoned.....

Date

OCT 9 1929

S. J. LEWIS Scout

Map No. 13 **KANSAS** Sec. 15 Twp. 26 R. 26

Well No. 3 Brown

Shell Pet Corp. Company

Contractor

SECTION PLAT

.....Ft. from N. Line

1070 Ft. from S. Line

250 Ft. from E. Line

.....Ft. from W. Line


COMPLETED

Location.....

Rig up.....

Drilling and Remarks:

Chat 2889-93

Swat 208 4 1/2

" 6 "

RECORD

Cased.....in., .....ft.

Sand.....

Gas.....

Oil.....

Total Depth 2899

PRODUCTION

1st 24 hrs. Nat.....

1st 24 hrs. after shot.....

Gas.....Cu. Ft.

Dry Hole.....

Abandoned.....

Date

NOV 6 1929

S. J. LEWIS Scout

13 KANSAS

Map No. Sec. 15 Twp. 26 R. 2 E

Well No. 3 Brown

Sheep per Co. Company

Contractor

FIRST REPORTS

SECTION PLAT

Ft. from N. Line

10.70 Ft. from S. Line

250 Ft. from E. Line

Ft. from W. Line


Location

Rig up

Drilling and Remarks:

old TD 2893  
6" 300r

RECORD

Cased in, ft.

Sand Top Chat 2889

Gas

Oil

Total Depth

PRODUCTION

1st 24 hrs. Nat.

1st 24 hrs. after shot

Gas Cu. Ft.

Dry Hole

Abandoned

Date

JUL 20 1932 CHAS. L. SHERWOOD

192 Scout

*Deeg West*

*13* KANSAS

Map No. .... Sec. *15* Twp. *26* R. *2* <sup>E</sup>

Well No. *3* *Brown*

*Shell pet Corp* Company

Contractor

COMPLETED

SECTION PLAT

..... Ft. from N. Line

*1070* Ft. from S. Line

*250* Ft. from E. Line

..... Ft. from W. Line


Location .....

Rig up .....

Drilling and Remarks:

*Pump 410 Bls  
in 24 Hrs.*

RECORD

Cased ..... in., ..... ft.

Sand *Viola 3202-05*

Gas .....

Oil .....

Total Depth *3205*

PRODUCTION

1st 24 hrs. Nat. ....

1st 24 hrs. after shot. ....

Gas ..... Cu. Ft.

Dry Hole .....

Abandoned .....

Date

AUG 17 1932

192

CHAS. L. SHERWOOD

Scout