

Company Brànine & Holl

WEST

EAST

SOUTH

Barton

KANSAS

Sec. 34 Twp. 18 R. 13W

Well No. #1 Rizha Farm

Branine & Holl Company

Contractor

Wildcat

Ft. from N. Line

330'


Ft. from S. Line

Ft. from E. Line

330'

Ft. from W. Line

SW SW SE

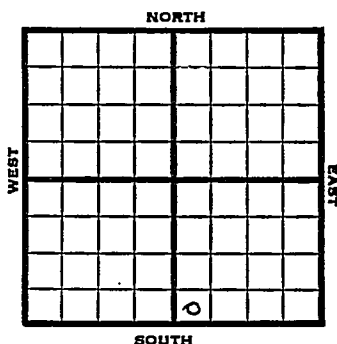

1951

Elev. 1857' REPORT

8/22

Spud 8-13-51

8" @ 190

Drlg. 2920'

8/29

Spud 8-13-51

D & A TD 3412' 8" @ 190

Heeb 3036' Br. lime 3125' KC 3139'

DST 3167-95 open $\frac{1}{2}$ hr. rec 12' mud


Cong. 3372' Arb. 3377'

DST 3378-87 open $\frac{1}{2}$ hr. rec 3' mud

TD 3412' D & A

ABANDONED

County Barton State Kansas
 Sec. 34 (^{Blk.}_{Twp.}) 18 (^{Sur.}_{Rge.}) 13W Map No. _____
 Operator Branine & Holl
 Well No. 1 Farm Rizha
 Elev. _____ Location SW SW SE

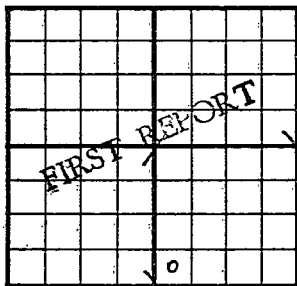


330 Ft. From S Line SE
330 Ft. From W Line Quarter
 Ist. Report AUG 22 1951
 Completion _____
 Remarks Magnolia DHM
 Spudding Date 8-13-51

Drlg. Data Wildcat
8" @ 190 drlg. 2920

J. E. TYRA

County Barton State Kansas
Rice
 Sec. 34 (Blk.) 18 (Sur.) 13W Map No.
 (Twp.)
 Operator Branine & Holl
 Well No. 1 Farm Rizha
 Elev. 1857 Location SW SW SE

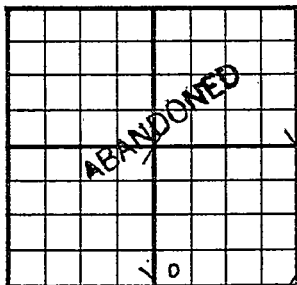

330 Ft. From S Line SE
330 Ft. From W Line Quarter
 1st. Report
 Completion AUG 29 1951
 Remarks Wildcat
 Spudding Date 8-13-51

Drig. Data D & A TD 3412
8" @ 190 Heeb. 3030 Br. lime 3125
KC 3139 DST 3167-95 open $\frac{1}{2}$ hr.
Rec. 12' mud Cong. 3372 Arb. 3377
DST 3378-87 open $\frac{1}{2}$ hr. Rec. 3' mud
TD 3412 D & A