


Section 34 Township 18 Range 13W

Well No. 2 Taylor

Company Toklan Production

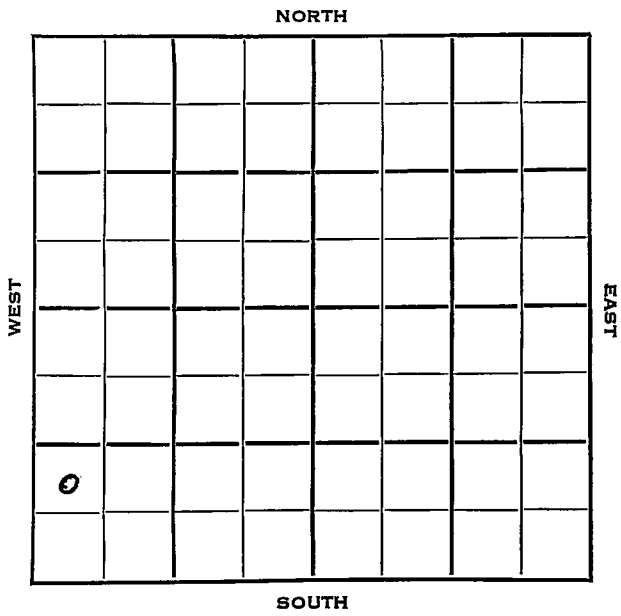

Barton KANSAS

SEC.	TWP.	R.
34	18	13W ✓

WELL NO.

2 Taylor

FARM

COMPANY

Toklan Production

CONTRACTOR

Rocket Drlg.

Hawkins Pool


_____ Ft. from N. Line

990 _____ Ft. from S. Line

_____ Ft. from E. Line

330 _____ Ft. from W. Line

NW SW SW

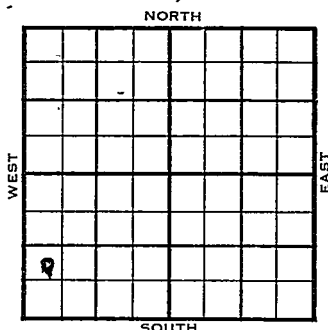

	ELEVATION	REPORT
1954	1902'	

3/17	Spud 3-14-54 8" @ 194' Anhy 785' rlg. 995'
3/24	Heeb 3074', Lans 3177' DST 3180-3240', 2 hrs., 120' O&GCM, 180' HO&GCM 1280# DST 3292-3352', 2 hrs., 1420' gas, 530' hly O & gcm Cong 3409', Arb. 3414' RTD 3420' 5" @ 3418'
3/31	DD 3421 50 A DD 3427 B/26 GOPH 100 A B/24 GOPH Sd-frac.
4/7	NR
4/28	Spud 3-14-54 Oil Well TD 3427' 8" @ 194' Anhy 785', Heeb 3074', Lans 3177' DST 3180'-3240' opn 2 hr, rec 120' o & gcm 180' ho & gcm 280# DST 3292'-3352' opn 2hr, rec 1420' gas 530' ho & gcm, Cong 3409 Arb 3414'

1954

Information brought forward.


4/28

TD 3420'
5" @ 3418'
DD 3421'
50 A DD 3427 B/ 26 goph 100 A
B/ 24 goph sd-frac
PB 3380'
15/ 3331-42 15/ 3323-26
35/ 3304-10 300 A S/ $1\frac{1}{2}$ boph
frac.
PB 3285'
16/ 3236-39 32/ 3226-32
47/ 3185-93 1000 A S/ $2\frac{1}{2}$ boph
sd-frac
S/ 2 boph CO to 3380
P/ 43 bo 36 bwpd
Comp 23 bopd 38% Wtr.

COMPLETED

J. G. McGEHEE

County Barton State Kansas
 Sec. 34 (Blk.) 18 (Sur.) 13W Map No.
 Operator Toklan Prod.
 Well No. 2 Farm Taylor
 Elev. 1902 Location NW SW SW

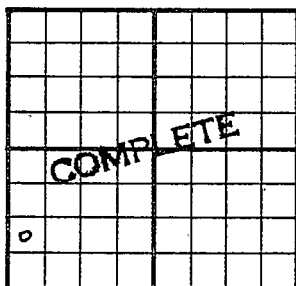

990 Ft. From S Line SW
330 Ft. From W Line Quarter
 Ist. Report
 Completion APR 28 1954
 Remarks Hawkins Pool
Rocket Drlg. - Contr.
 Spudding Date 3-14-54

Drlg. Data Oil well TD 3427
8" @ 194 Anhy 785 Heeb. 3074
Lans. 3177 DST 3180-3240 open 2 hr.
Rec. 120' o & gcm 180' ho & gcm 280#
DST 3292-3352 open 2 hr. Rec. 1420' gas
530' ho & gcm Cong. 3409 Arb. 3414
TD 3420 5" @ 3418 DD 3421 50 A
DD 3427 B/ 26 goph 100. A B/ 24 goph
sd-frac PB 3380 15/ 3331-42 15/ 3323-
26. 35/ 3304-10 300 A S/ 1½ boph
frac PB 3285 16/ 3236-39 32/ 322-6-32
47/ 3185-93 1000 A S/ 2½ boph sd-frac
S/ 2 boph CO to 3380 P/ 43 ho 36 bwpd
Comp. 23 bopd 38% wtr.

J. G. McGEHEE