

Barton


KANSAS

SECTION 28 TOWNSHIP 20 RANGE 12W

WELL NO. #6 Spacil

COMPANY Alpine Oil & Royalty

NORTH

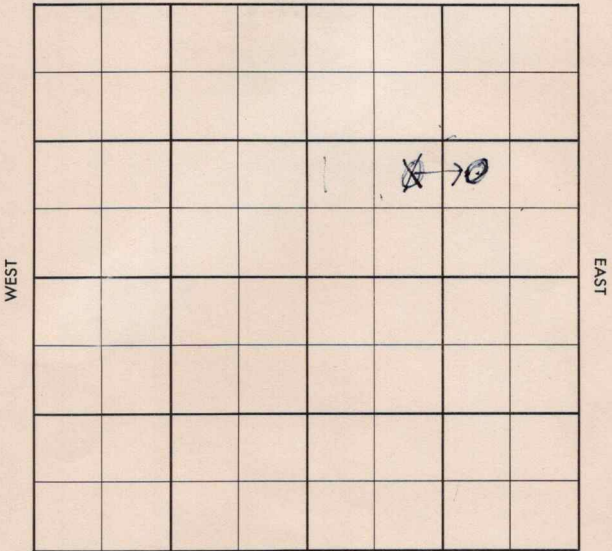

SOUTH


WEST

EAST

County Bayton Elev. _____
 Sec. 28 Twp. 20 Rge. 12W
 Company Alpine Oil & Royalty
 FarmName Spacil No. 6

TOPS	DEPTH	LOG	DATUM
Anh.			
Tp.			
H.			
Tr.			
Dg.			
Bl.			
L.			
K.C.			
B.K.C.			
Ce.			
C.			
M.			
M.			
K.			
Mz.			
Me.			
V.			
S.			
S.			
A.			
R.			
Pe.			
G.			
T.D.			

Loc. in Sec. NE SW NE
 Geol. _____
 Contr. Quaker
 Pool _____

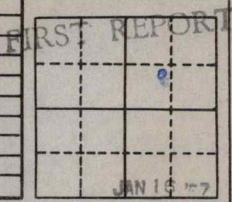

Date Comm. 1-12-57
8" @ 253/125 dl.g. 1765

~~13~~

Co.
Lse.
No.
Sec.
T.
R.

CORRECTION

FORM 513 SUNRAY

County Barton Elev. 1240
 Sec. 28 Twp. 20 Rge. 12W
 Company Alpine Oil & Royalty
 Farm Name Spacil No. 6

TOPS	DEPTH	LOG	DATUM	Loc. Sec
Anh.	620			NW SE NE SW NE
Tr.	3029			
Dg.				1240 NE
Bl.	3154			1220 SW
L.	3171			Geol.
K.C.				Contr.
B.K.C.				Quaker
Ce.				Pool
C.				0
M.				FEB 20 '57
M.				
K.				COMPLETE
Mz.				
Mo.				
V.				
S.				
A	3413			
R.				
PE				
G.				
TD	3442			

Date Comm. 1-12-57

8" @ 253/125 me. 1765 JAN 23 '57 DST

3197-3266 1 hr rec 80' MW

BHP 1120/20" 4 1/2 3415 WOCT

JAN 30 '57 WOCT FEB 6 '57 WOCT FEB 13 '57

CO 3442 FU 1600' oil to acid

FEB 20 '57 1/2 \$ 45 BO \$ 3

Boph. 6 hrs T&R Pop

P. 25 Bopd no wt.