


Cawley LOG

Map No. Kans Sec. 4 Twp. 30 R. 8

Well No. 4 Hannock Farm
C. E. Rath Company

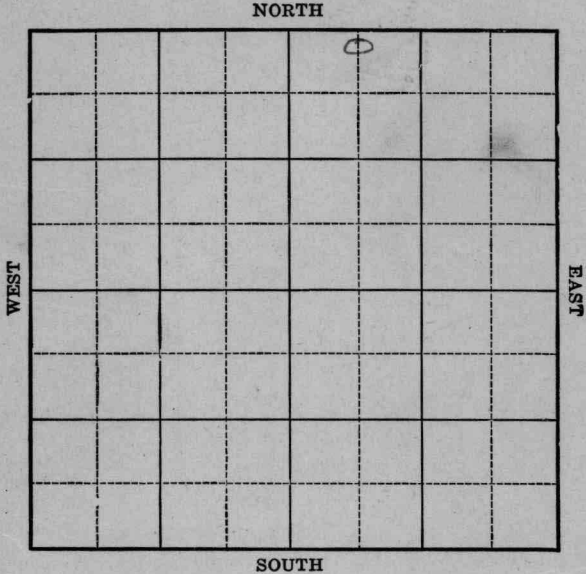

Location _____
Drilling Remarks _____

Rig Up _____
Drilling Remarks _____

RECORD

PRODUCTION

Cased _____ in. _____ ft.
Sand _____
Gas _____
Oil _____
Total Depth _____

1st 24 hrs. Nat. _____
1st. 24 hrs. after shot _____
Gas _____ cu. ft.
Dry Hole _____
Abandoned _____

Cowley

Map No. Kans Sec. 4 Twp. 30 R. 8


Well No. #4 Hannock Farm
C. E. Rath Company

200 Ft. from N. Line

_____ Ft. from S. Line

_____ Ft. from E. Line

660 Ft. from W. Line

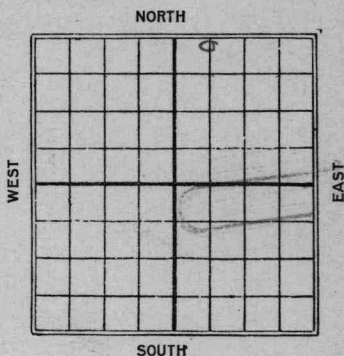

Date	REPORT
1924 12/30	Sly 2000'
1925 1/26	Top 2090-2113 Well made 2 flows of 100 Bbls Shut down and quite flowing (Tel)
1/24	(Note Sand Record OFF OF Books show 2113-29 Sly deeper)
3/30	Sand 2113-32 140 gts Pumping 90 Bbls

Cawley

Map No. 10 Sec. 4 Twp. 30 R. 8

Well No. #4 Hannah

C E Ruth Company

Contractor

FIRST REPORTS

200 Ft. from N. Line

_____ Ft. from S. Line

_____ Ft. from E. Line

660 Ft. from W. Line

SECTION PLAT

		○	

Location _____

Rig up _____

Drilling and Remarks:

D-2000

RECORD

Cased _____ in., _____ ft.

Sand _____

Gas _____

Oil _____

Total Depth _____

PRODUCTION

1st 24 hrs. Nat. _____

1st 24 hrs. after shot _____

Gas _____ Cu. Ft.

Dry Hole _____

Abandoned _____

Date

12-30-4

M.A.S.

Scout

10 KANSAS Map No. Sec. 4 Twp. 30 R. 8

Well No. 4 Hannah Company
C. E. Rath, Contractor

COMPLETED SECTION PLAT

200 Ft. from N. Line

----- Ft. from S. Line

----- Ft. from E. Line

660 Ft. from W. Line

		0	

Location -----

Rig up ----- *Line*

Drilling and Remarks:

*140 gals shot
pumping 90
lbs.*

RECORD

Cased ----- in., ----- ft.

Sand *2113-2132*

Gas -----

Oil -----

Total Depth *2132*

PRODUCTION

1st 24 hrs. Nat. -----

1st 24 hrs. after shot -----

Gas ----- Cu. Ft.

Dry Hole -----

Abandoned -----

Date

3/30 192*5*

M. A. BENEAR

Scout