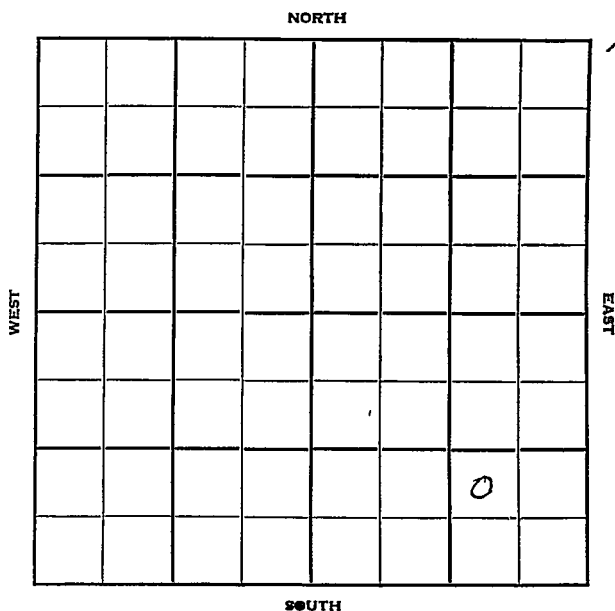


Section 1 Township 18 Range 14WWell No. #2 RiedelCompany Continental Oil

KANSAS

Barton

Sec. 1 Twp. 18 R. 14W ✓

Well No. #2 Riedel Farm

Continental Oil Company

Eveleigh Pool Contractor


 Ft. from N. Line

990' Ft. from S. Line

990' Ft. from E. Line

 Ft. from W. Line

NW SE SE

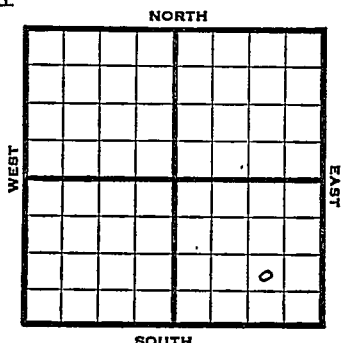

1950

Elev. ~ 1837' REPORT


11/29

Location

12/13

D&A TD 3365
13" @ 183' Anhy 790'
9-5/8" @ 800'
Lans. 3099' Arb. 3331
DST 3332-34 opn 1 hr
Rec. 20' mud TD 3365
D&A **ABANDONED**

FM TVDA

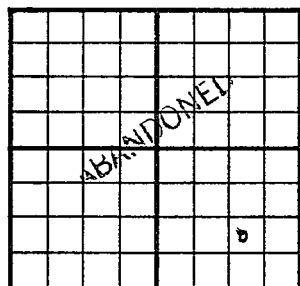County Barton State KansasSec. 1 (Blk. 18 (Sur. 14W Map No. (Twp.) (Rge.)Operator Continental OilWell No. 2 Farm RiedelElev. 1837 Location NW SE SE990 Ft. From S Line SE990 Ft. From E Line Quarter1st. ReportCompletion DEC 13 1950Remarks Eveleigh PoolSpudding DateDrilg. Data D & A TD 336513" @ 183 Anhy 790 9 5/8" @ 800Lans. 3099 Arb. 3331 DST 3332-34open 1 hr. Rec. 20' mud TD 3365D & A

J. E. TYRA