
FORM 51 25M 8-50 WESTERN

Barton KANSAS

Section 29 Township 20 Range 12 W

Well No. # 1 Simpson

Company LaFayette Oil

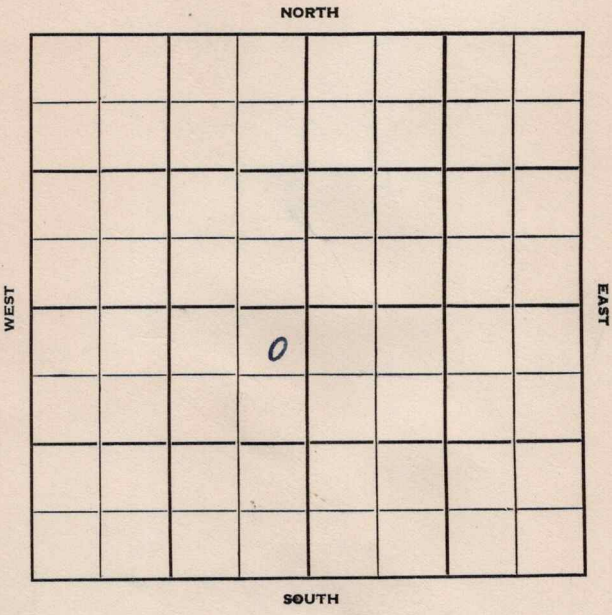

FORM 252-B

Barton KANSAS

Sec. 29 Twp. 20 R. 12 W

Well No. # 1 Simpson Farm

LaFayette Oil Company

Schaffer Contractor


330 Ft. from N. Line

Ft. from S. Line

330 Ft. from E. Line

Ft. from W. Line

NE NE SW

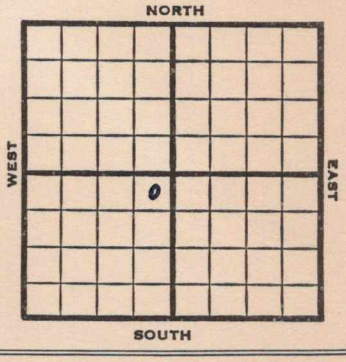

1953	Elev. 1855' REPORT
6/24	Spud 6-9-53 D & A TD 3586' 8" @ 216 Heeb 3064 Br lime 3187 KC 3205 DST 3222-40 open 1 hr rec 60' oil spotted mud. 140# DST 3332-41' open ½ hr. rec 10' mud 875# Cong. 3436 Arb. 3556 TD 3586' D & A FIRST REPORT ✓ ABANDONED

FORM 275 FOR SALE BY KANSAS BLUE PRINT CO.

County Barton State Kansas

Sec. 29 (Blk. Twp.) 20 (Sur. Rge.) 12W Map No.

Operator LaFayette Oil

Well No. 1 Farm Simpson

Elev. 1855 Location NE NE SW



330 Ft. From N Line SW

330 Ft. From E Line Quarter

1st. Report JUN 24 1953

Completion JUN 24 1953

Remarks

Schaffer - Contr.

Spudding Date 6-9-53

Drlg. Data D & A TD 3586

8" @ 216 Heeb. 3064 Br. lime 3187

KCns 3205 DST 3222-40 open 1 hr.

Rec. 60' oil spotted mud 140#

DST 3352-41 open ½ hr. Rec. 10' mud

875# Cong. 3436 Arb. 3556 TD 3586

D & A

J. G. McGEHEE